2:30

IREDELL COUNTY HEALTH DEPARTMENT

STATESVILLE 704-878-5305 MOORESVILLE 704-664-5281

IMPROVEMENT PERMIT / AUTHORIZATION TO CONSTRUCT / OPERATION PERMIT / EXISTING SYSTEM INSPECTION

PERMIT# 148404 PIN# 4833358967 5590 DATE 3-12-08

OWNER OR APPLICANT David Southos PHONE: Business 704 253 3535 Home 704 592 4803

ADDRESS 2643 W. Memorial Hwy

LOCATION Hwy 115 N, Rt. on 901 1on (R)

SUBDIVISION ~~Covington~~ Covington Farms BLOCK / SECTION _____ LOT 3 LOT AREA 8.907 SITE CLASS. PS DESIGN FLOW 720 L.T.A.R. .3

Septic Tank: 1500 Gallons; STB 268 Date 3-17-08

Pump Tank: _____ Gallons; PT _____ Date _____

Pump Make: _____ Model _____ Serial No. _____

Nitrification Field: No Fields 1 Square Feet 2400 Linear Feet 600

No Lines 5 Trench Width 36" Max Trench Bottom Depth 30" Gravel Depth n/a Gravity ☐ Pressure

☒ New System ☐ Repair ☐ Expansion System Type: I II (III) IV V VI

System Description: 25% Reduction Gravity

Repair System Description: 25% Reduction Gravity

Maintenance Agreement Required: ☐ Yes ☒ No

☒ House/Mod. Home ☐ Mobile Home ☐ Business ☐ Other

No. Bedrooms 6 No. Persons ____ No. Employees ____

Water Supply: ☒ Individual ☐ Public ☐ Community

☐ Slab ☒ Crawl Space ☐ Basement w/plumbing ☐ Basement wo/plumbing


Comments:/Conditions:

(5) 120' x 3' Lines

Comments:/Conditions:

Brown Filter

INITIAL SITE SKETCH

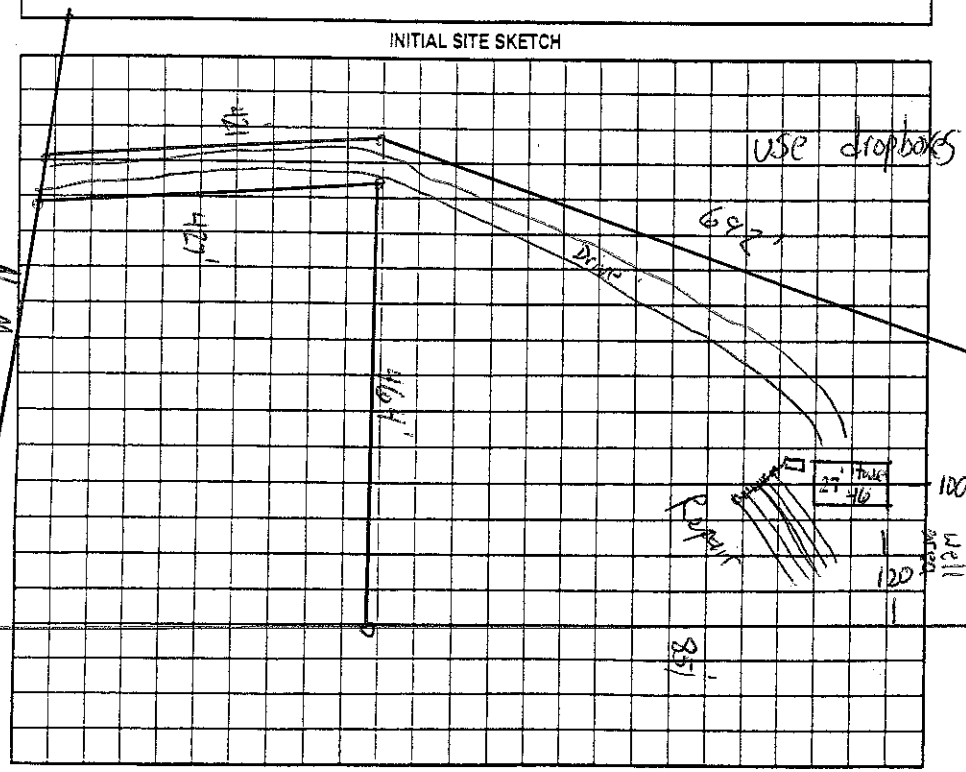

AS BUILT SKETCH

Permit can be suspended or revoked if any false information is supplied toward securing the permit/any unauthorized changes are made to the site/any unauthorized changes are made in the installation of the system. Improvement Permit with plat valid without expiration ☐ Improvement Permit with site plan valid for sixty months ☒ Authorization to Construct is valid for a period equal to that of Improvement Permit – not to exceed sixty months.

Signed: _____ date 3/25/08 Installed by: Alexander

Improvement Permit by: _____ date 3-12-08 Operation Permit by: _____ date 5-13-08

Authorization to Construct by: _____ date 3-12-08 Existing System Inspection by: _____ date _____

HEALTH DEPT. COPY: WHITE OWNER COPY (FINAL): YELLOW OWNER COPY (INITIAL): PINK