IREDELL COUNTY HEALTH DEPARTMENT

4833-50-0780

STATESVILLE 704-878-5305 MOORESVILLE 704-664-5281

IMPROVEMENT PERMIT / AUTHORIZATION TO CONSTRUCT / OPERATION PERMIT / EXISTING SYSTEM INSPECTION

PERMIT# 11626 PIN# ~~4833-40-4777~~ LEE BUGGS CLAYTON HOMES DATE 10-1-03

OWNER OR CONTRACTOR DALE WILLIAMS PHONE: Business 704-450-4217 Home

ADDRESS 124 BULLDOZER LANE OLIN, NC 28660

LOCATION 901 WEST ON MYERS MILL, ON BULLDOZER, ON PT

SUBDIVISION BLOCK / SECTION LOT LOT AREA 29.7 AC SITE CLASS. PS DESIGN FLOW 360 L.T.A.R. .13

Septic Tank: 1000 Gallons; STB Date

Pump Tank: Gallons; PT Date

Pump Make: Model Serial No.

Nitrification Field: No Fields 1 Square Feet 66 x 120 Linear Feet 160'

No Lines 2 Trench Width 36" Max Trench Bottom Depth 36" Gravel Depth 12"

☒ New System ☐ Repair System Type: I, (II), III, IV, V, VI

System Description: CONV GRAV

Repair System Description: PUMP/GRAV CONV

Maintenance Agreement Required: ☐ Yes ☒ No

☐ House/Mod. Home No. Bedrooms 3

☒ Mobile Home S/W No. Bathrooms 2

☐ Business No. Employees

☐ Other


☐ Slab ☒ Crawl Space ☐ Basement w/plumbing ☐ Basement wo/plumbing

Water Supply: ☒ Individual ☐ Public ☐ Community

Comments:/Conditions: (1) REPRESENT WITH OLD 14X56 S/W SET (2) REPRESENTS WHERE NEW/LONGER S/W WILL SET (3) INSTALL 2 NEW 80' LINES & TIE INTO EXISTING DIST BOX (4) MAINTAIN SETBACKS

Comments:/Conditions: (5) VERBAL AGREEMENT BY JIM SHACKLEFF WITH CRESENT/ENERGY UNITED ON 10-1-03 VIA PHONE 336-751-3029, TO ALLOW SEPTIC FIELD PLACEMENT IN THEIR POWER LINE R/O/W, DO NOT SIGN OFF ON OPERATION PERMIT UNTIL AGREEMENT LETTER IS RECEIVED/LL

INITIAL SITE SKETCH

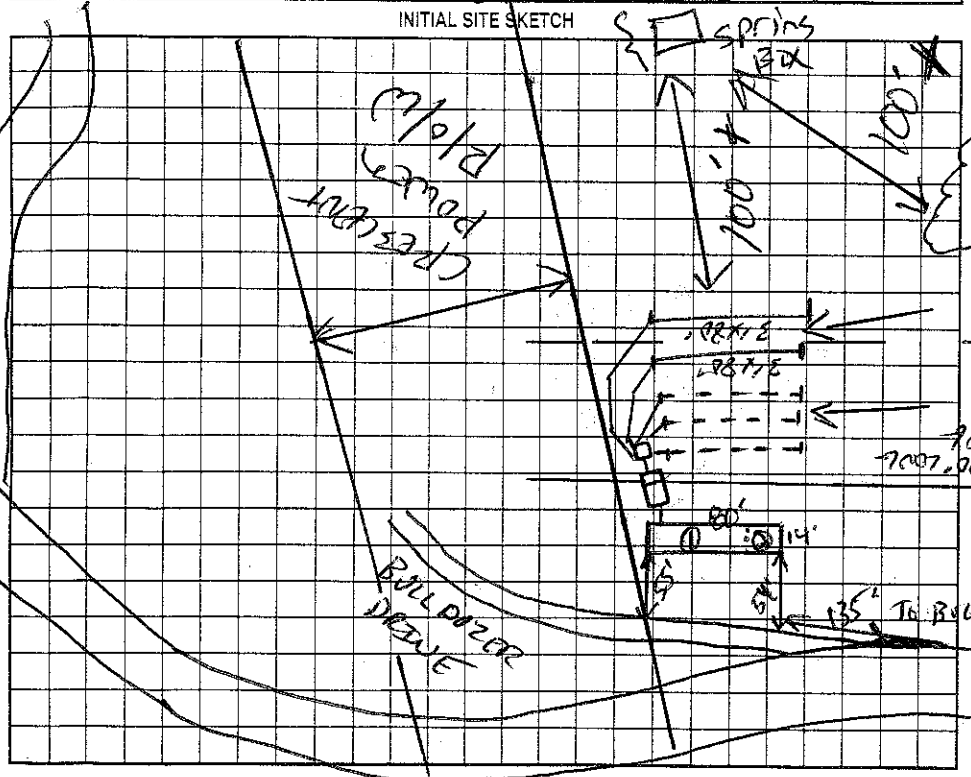

AS BUILT SKETCH

W'D LINES & SYSTEM, OK 10-6-03 LL

WAITING ON LETTER FROM JIM SHACKLEFF RECEIVED LETTER ON 10-6-03 IN AFTERNOON. LL

Permit can be suspended or revoked if any false information is supplied toward securing the permit/any unauthorized changes are made to the site/any unauthorized changes are made in the installation of the system. Improvement Permit with plat valid without expiration. Improvement Permit with site plan valid for sixty months. Authorization to Construct is valid for a period equal to that of Improvement Permit – not to exceed sixty months.

Signed: date 10/2/03 Installed by: DALE WILLIAMS

Improvement Permit by: date 10-1-03 Operation Permit by: date 10-7-03

Authorization to Construct by: date 10-1-03 Existing System Inspection by: date

HEALTH DEPT. COPY: WHITE OWNER COPY (FINAL): YELLOW OWNER COPY (INITIAL): PINK