IREDELL COUNTY HEALTH DEPARTMENT

STATESVILLE 704-878-5305 MOORESVILLE 704-664-5281

IMPROVEMENT PERMIT / AUTHORIZATION TO CONSTRUCT / OPERATION PERMIT / EXISTING SYSTEM INSPECTION

PERMIT # Repair PIN # 4833-94-7594 DATE 29 JANUARY 2010

OWNER or APPLICANT Jonathon WALKER PHONE: ~~Business~~ cell (704) 980-4035 Home:

OWNER or APPLICANT ADDRESS 760 Indian Hill Rd. UNION County, NC.

LOCATION / DIRECTIONS Jamestown Rd TL Indian Hill Rd. RT Rt. before Hwy 901

SUBDIVISION BLOCK / SECTION LOT # LOT AREA DESIGN FLOW L.T.A.R.

Septic Tank 1000 Gallons: STB 620 Date 8-25-09

Pump Tank Gallons: PT Date

Pump Make Model Serial #

Nitrification Field No Fields NA No Lines NA Linear Feet NA

Trench Width NA Max. Trench Bottom Depth NA Gravel Depth NA

☐ New System ☑ Repair ☐ Expansion System Type I II III IV V VI

System Description: New 1000g ST

Repair System Description:

Maintenance Agreement Required ☐ YES ☑ NO

☐ GRAVITY ☐ PRESSURE

☑ Residence No. Bedrooms 3

☐ Business No. Persons

☐ Other No. Employees

☐ Slab ☑ Crawl Space

☐ Basement w/plumbing ☐ Basement w/o plumbing


Water Supply: ☐ Private ☒ Public ☐ Community

Comments / Conditions

Comments / Conditions Push/Rock fill Yes

INITIAL SITE SKETCH

AS BUILT SKETCH

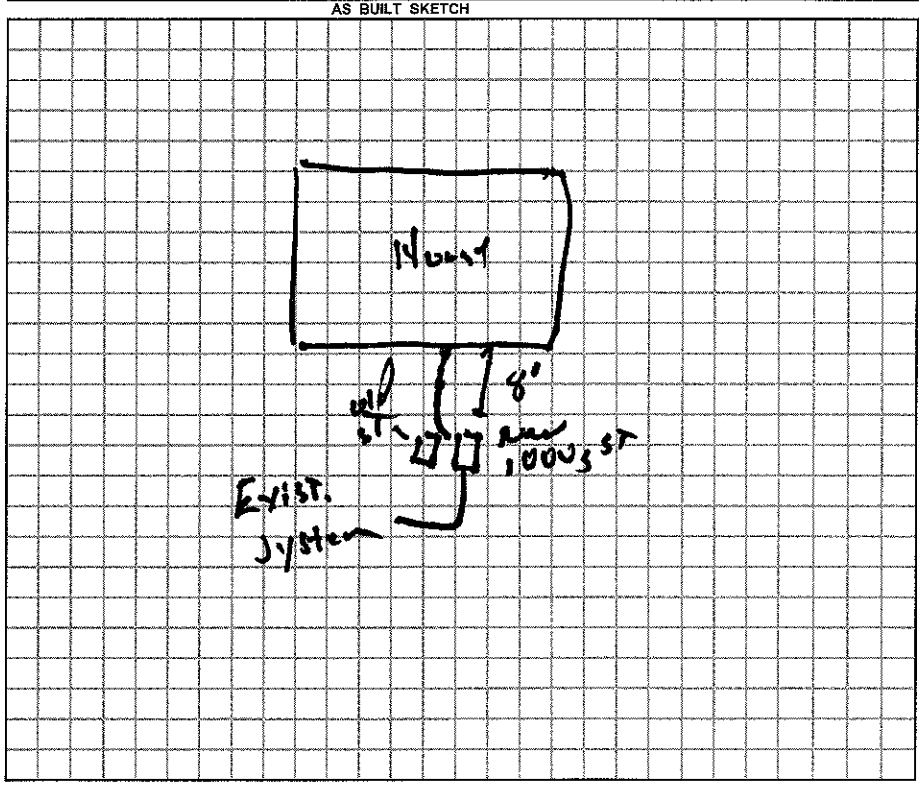

Permit can be suspended or revoked if any false information is supplied toward securing the permit / any unauthorized changes are made to the site / any unauthorized changes are made in the installation of the system.

☐ *IMPROVEMENT PERMIT w / plat valid without expiration.* ☑ *IMPROVEMENT PERMIT w / site plan valid for 60 mos.* ☑ *AUTHORIZATION TO CONSTRUCT valid for period equal to IMPROVEMENT PERMIT-not to exceed 60 mo.*

Owner / Applicant Signature: Date

Improvement Permit by: Date

Authorzation to Construct by: R.S Date 29 Jan. 2010

Installed by: Tyler JORDAN

Operation Permit by: R.S Date: 29 Jan. 2010

Existing System Inspected by: Date:

YOU SHOULD CONTACT A LOCATOR SERVICE PRIOR TO ANY EXCAVATION.

WHITE COPY Environmental Health YELLOW COPY (Final) Owner / Applicant PINK COPY (Initial) Owner / Applicant