BENNY McCANN

IREDELL COUNTY HEALTH DEPARTMENT

STATESVILLE 704-878-5305 (E1) MOORESVILLE 704-664-5281

IMPROVEMENT PERMIT / AUTHORIZATION TO CONSTRUCT / OPERATION PERMIT / EXISTING SYSTEM INSPECTION

(E) PERMIT# 106936 PIN# 4834-11-0865 DATE 6-27-02

OWNER OR CONTACT BENNY McCANN PHONE: Business _____ Home 704-592-7383

ADDRESS 580 GRASSY KNOB ROAD UNION GROVE, NC 28689

LOCATION NC 115 N, TR NC901, TL GRASSY KNOB ROAD, LAST DRIVE ON LEFT BEFORE CHURCH (AT #317)

SUBDIVISION _____ BLOCK / SECTION _____ LOT _____ LOT AREA 50.10 ACRES SITE CLASS PS DESIGN FLOW 240 L.T.A.R. 0.30 GPD/FT²

Septic Tank: 1000 Gallons; STB 1007 Date 6-6-02
Pump Tank: _____ Gallons; PT _____ Date _____
Pump Make: _____ Model _____ Serial No. _____
Nitrification Field: No Fields 1 Square Feet 810 Linear Feet 270
No Lines THREE Trench Width 36" Max Trench Bottom Depth 24"

☑ New System ☐ Repair System Type: I. II. III. IV. V. VI
System Description: CONVENTIONAL, GRAVITY
Repair System Description: CONVENTIONAL, GRAVITY
Maintenance Agreement Required: ☐ Yes ☑ NO
Gravel Depth 12" ☐ Slab ☑ Crawl Space ☐ Basement w/plumbing ☐ Basement wo/plumbing


☐ House/Mod. Home No. Bedrooms 2
☑ Mobile Home No. Bathrooms 1
☐ Business No. Employees _____
☐ Other _____

Water Supply: ☑ Individual ☐ Public ☐ Community
WELL

Comments/Conditions: ① SYSTEM SIZED FOR TWO BEDROOMS ONLY ② INSTALL LINES ON CONTOUR, NO DEEPER THAN 24"

Comments/Conditions: SEPTIC TANK WITH MARKER INSTALLED USING "ZABEL" FILTER

INITIAL SITE SKETCH

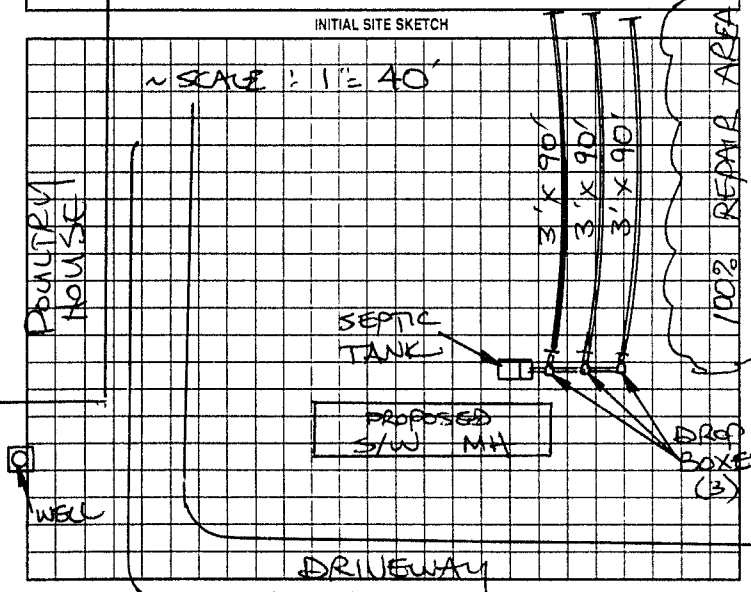

AS BUILT SKETCH

SYSTEM INSTALLED ACCORDING TO INITIAL SITE SKETCH

Permit can be suspended or revoked if any false information is supplied toward securing the permit/any unauthorized changes are made to the site/any unauthorized changes are made in the installation of the system. Improvement Permit with plat valid without expiration. Improvement Permit with site plan valid for sixty months. Authorization to Construct is valid for a period equal to that of Improvement Permit – not to exceed sixty months

Signed: Benny McCann date 6/27/02 Installed by: JAMES HUDLER

Improvement Permit by: STEVE HEDRICK date 6-27-02 Operation Permit by: STEVE HEDRICK date 7-19-02

Authorization to Construct by: STEVE HEDRICK date 6-27-02 Existing System Inspection by: _____ date _____

HEALTH DEPT. COPY WHITE OWNER COPY (FINAL) YELLOW OWNER COPY (INITIAL) PINK