IREDELL COUNTY HEALTH DEPARTMENT

STATESVILLE 704-878-5305 MOORESVILLE 704-664-5281

IMPROVEMENT PERMIT / AUTHORIZATION TO CONSTRUCT / OPERATION PERMIT / EXISTING SYSTEM INSPECTION

PERMIT# 074789 PIN# 4834 23 0205 (PT) DATE 9-21-98

OWNER OR CONTRACTOR TABASSA GRAVES PHONE: Business Home 592-5382

ADDRESS 449 GRASSY KNOB ROAD, UNION GROVE, NC 28689

LOCATION NC 115 N, TR NC 901, TL GRASSY KNOB TL BARKHOUSE LANE, 1ST MH ON LEFT

SUBDIVISION BLOCK / SECTION LOT LOT AREA 2.12 ACRES SITE CLASS. PS DESIGN FLOW 360 L.T.A.R. 0.40 GPD/FT²

Septic Tank: 1000 Gallons; STB Date
Pump Tank: Gallons; PT Date
Pump Make: Model Serial No.
Nitrification Field: No Fields 1 Square Feet 900 Linear Feet 300
No Lines THREE Trench Width 36" Max Trench Bottom Depth 30" Gravel Depth 12"

☑ New System ☐ Repair System Type: I, II, III, IV, V, VI
System Description: CONVENTIONAL GRAVITY
Repair System Description: CONV. GRAVITY
Maintenance Agreement Required: ☐ Yes ☑ No

☐ House/Mod. Home No. Bedrooms 3
☑ Mobile Home No. Bathrooms 2
☐ Business No. Employees
☐ Other


☐ Slab ☑ Crawl Space ☐ Basement w/plumbing ☐ Basement wo/plumbing

Water Supply: ☑ Individual ☐ Public ☐ Community
WELL NEXT DOOR


Comments:/Conditions: KEEP SYSTEM MINIMUM 100' FROM ANY WELL

Comments:/Conditions:

INITIAL SITE SKETCH SCALE: 1"=50'

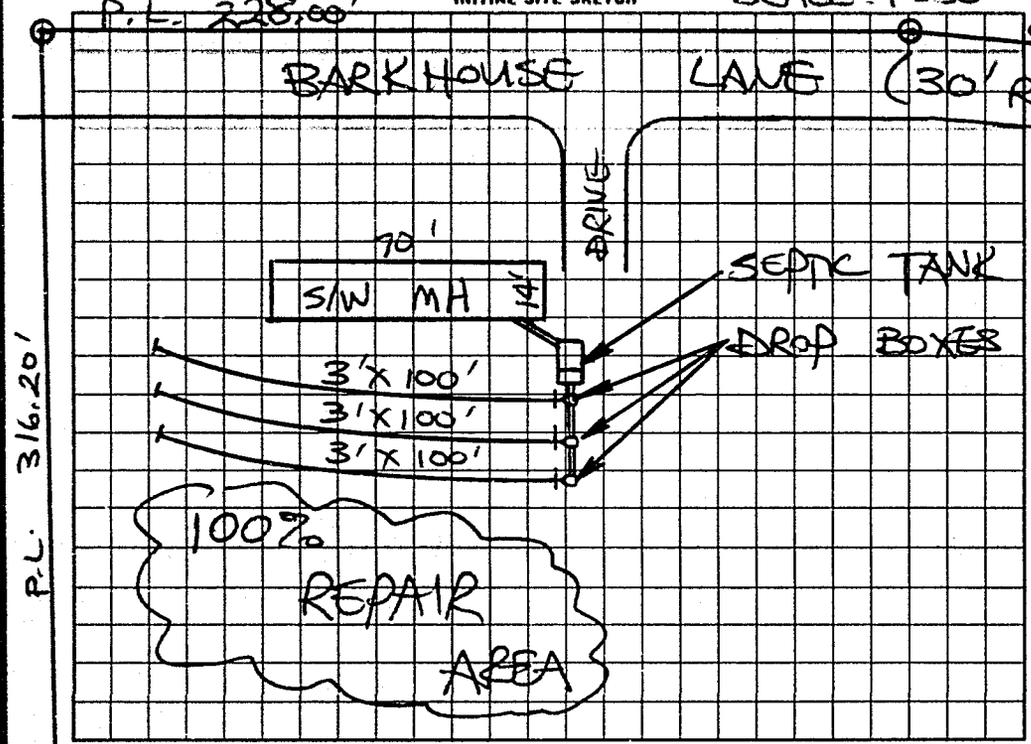

AS BUILT SKETCH

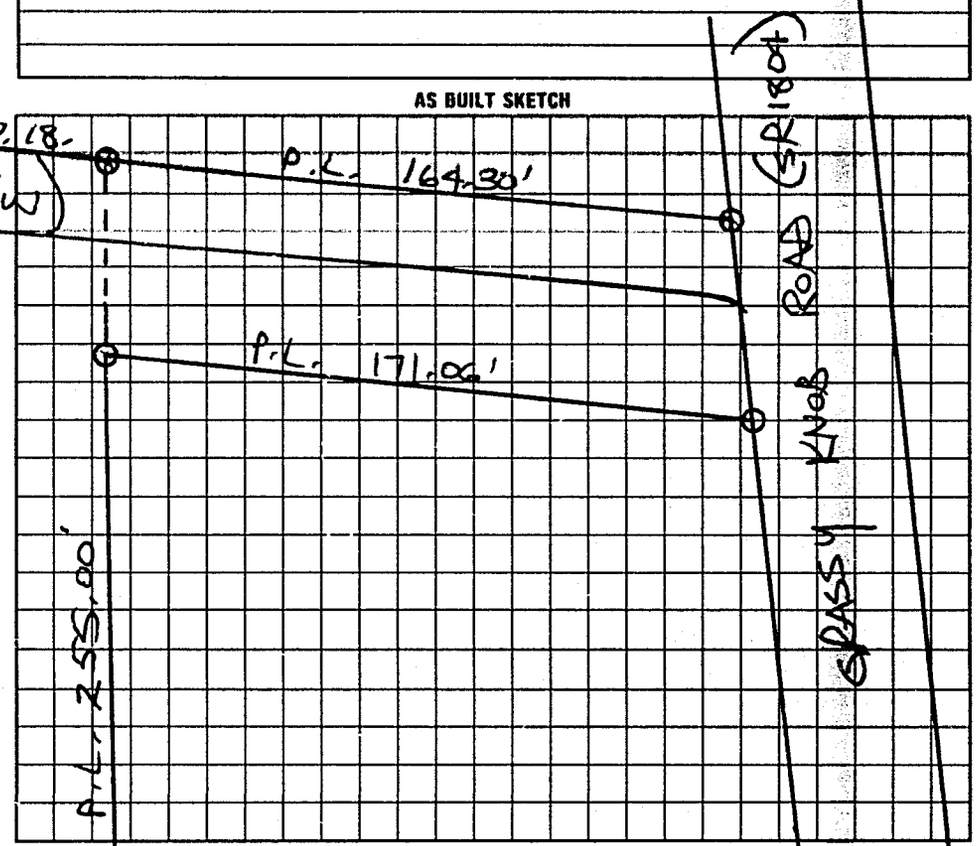

I understand that this permit can be suspended or revoked if any false information is supplied toward securing the permit/any unauthorized changes are made to the site/any unauthorized changes are made in the installation of the system. Improvement Permit with plat valid without expiration. Improvement Permit with site plan valid for sixty months. Authorization to Construct is valid for a period equal to that of Improvement Permit – not to exceed sixty months.

Signed: [signature] date

Improvement Permit by: STEVE HEDRICK date 9-21-98

Authorization to Construct by: STEVE HEDRICK date 9-21-98

Installed by: HICKORY BACKHOE INC (BILLY ECKARD)

Operation Permit by: STEVE HEDRICK date 9-29-98

Existing System Inspection by: date

HEALTH DEPT. COPY. WHITE INSPECTION COPY (FINAL). GREEN OWNER COPY (FINAL). YELLOW INSPECTION COPY (INITIAL). PINK OWNER COPY (INITIAL). GOLD