IREDELL COUNTY HEALTH DEPARTMENT

STATESVILLE 704-878-5305 MOORESVILLE 704-664-5281

IMPROVEMENT PERMIT / CERTIFICATE OF COMPLETION / OPERATION PERMIT / EXISTING SYSTEM INSPECTION

PROPERTY DESCRIPTION NO. 21248 DATE 5/31/95 TAX MAP NO. 15Q - A - 9 Watershed: ☐ Yes ☒ No

OWNER OR CONTRACTOR TROY C. NICHOLSON PHONE: Business Home 592-5302

ADDRESS 449 GRASSY KNOB ROAD, UNION GROVE, NC 28689

LOCATION NC 115 N, TR NC 901, TL GRASSY KNOB RD, 2ND HOUSE ON (L) PAST BUTCH BRANCH

SUBDIVISION BLOCK / SECTION LOT LOT AREA 1 ACRE SITE CLASS. PS DESIGN FLOW EXISTING I.A.R. EXISTING

Septic Tank: EXISTING Gallons; STB Date

Pump Tank: Gallons; PT Date

Pump Make: Model Serial No.

Nitrification Field: No Fields Square Feet Linear Feet EXISTING

No Lines Trench Width Max Trench Bottom Depth Gravel Depth

☐ New System ☐ Repair System Type: I, II, III, IV, V, VI

System Description: CONV. GRAVITY

Repair System Description: CONV. GRAVITY

Maintenance Agreement Required: ☐ Yes ☒ No

☒ House/Mod. Home No. Bedrooms

☐ Mobile Home No. Bathrooms

☐ Business No. Employees

☐ Other ADDITION

☐ Slab ☐ Crawl Space ☐ Basement w/plumbing ☒ Basement wo/plumbing


Water Supply:
☐ Individual
☐ Community
☐ Public

Comments:

Comments:
TOTAL NUMBER BEDROOMS 11 UNCHANGED.

INITIAL SITE SKETCH

AS BUILT SKETCH

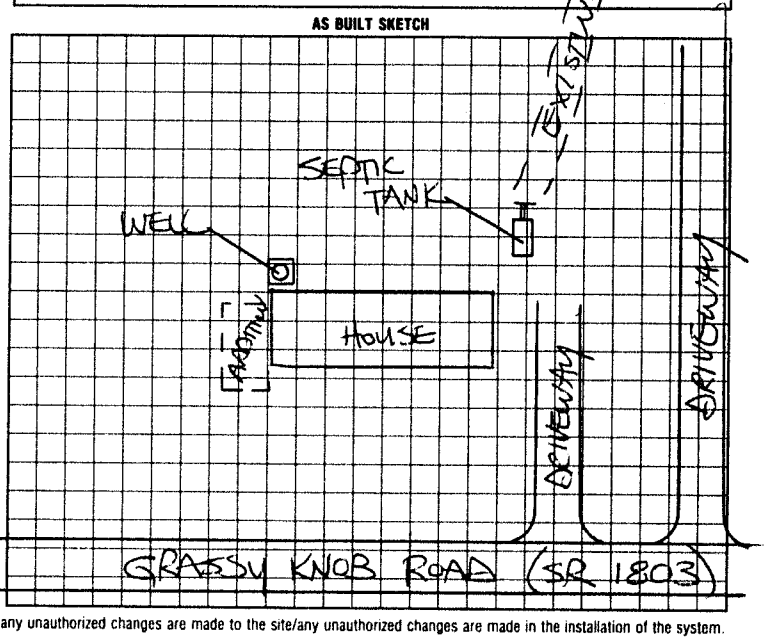

I understand that this permit can be suspended or revoked if any false information is supplied toward securing the permit/any unauthorized changes are made to the site/any unauthorized changes are made in the installation of the system. Improvement Permit is valid for 60 months from date of issuance.

Signed:

Improvement Permit by: date

Existing System Inspection by: STEVE HEDRICK date 5/31/95

Installed by:

Certificate of Completion by: date

Operation Permit by: date

HEALTH DEPT. COPY: WHITE INSPECTION COPY (FINAL): GREEN OWNER COPY (FINAL): YELLOW INSPECTION COPY (INITIAL): PINK OWNER COPY (INITIAL): GOLD