200

IREDELL COUNTY HEALTH DEPARTMENT

STATESVILLE 704-878-5305 MOORESVILLE 704-664-5281

IMPROVEMENT PERMIT / AUTHORIZATION TO CONSTRUCT / OPERATION PERMIT / EXISTING SYSTEM INSPECTION

PERMIT# 73027 PIN# 4834 60 8037 DATE 10-7-98

OWNER OR CONTRACTOR Clint VanHoy PHONE: Business _____ Home 539 4887

ADDRESS 397 Butch Branch Rd Union Grove

LOCATION I-77 TL 901 TR Warren Bridge TL Butch Branch Imit on left

SUBDIVISION _____ BLOCK / SECTION _____ LOT _____ LOT AREA 62.04 acres SITE CLASS PS DESIGN FLOW 360 L.T.A.R. .33

Septic Tank: 1000 Gallons; STB 1210 Date 12-2098

Pump Tank: _____ Gallons; PT _____ Date _____

Pump Make: _____ Model _____ Serial No _____

Nitrification Field: No Fields 1 Square Feet 1080 Linear Feet 360

No Lines 3 Trench Width 36" Max Trench Bottom Depth 36" Gravel Depth 12"

✓ New System Repair System Type: I II III IV V VI

System Description Conv. Gravity

Repair System Description: " "

Maintenance Agreement Required: Yes ✓ No

✓ House/Mod. Home No. Bedrooms 3

Mobile Home No. Bathrooms 3

Business No. Employees _____

Other _____


Slab ✓ Crawl Space Basement w/plumbing Basement wo/plumbing

Water Supply: ✓ Individual ☐ Public ☐ Community


Comments/Conditions:

Comments/Conditions:

INITIAL SITE SKETCH

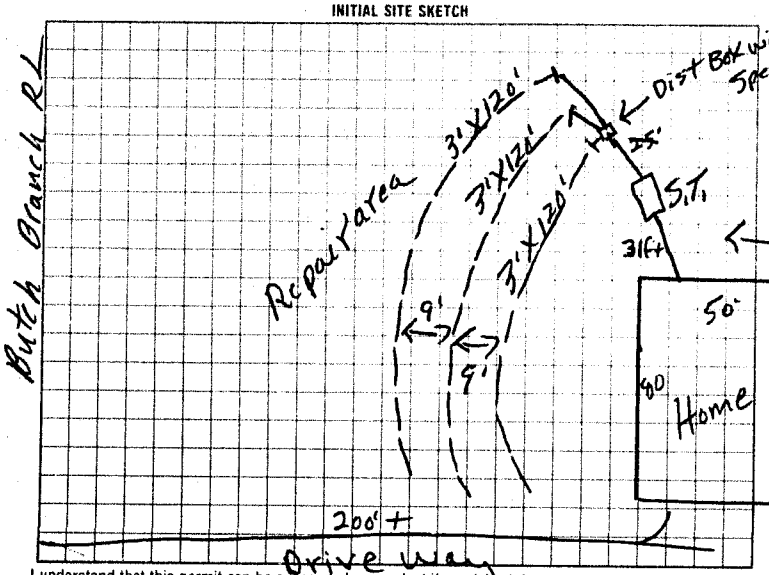

AS BUILT SKETCH

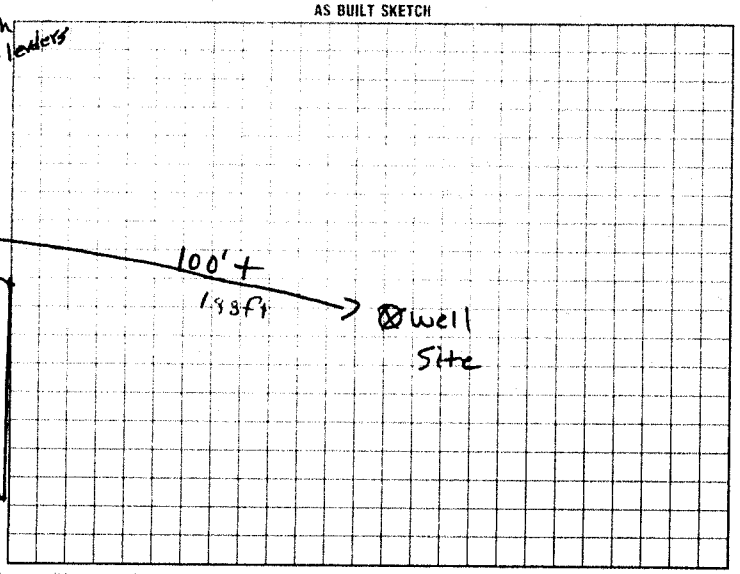

I understand that this permit can be suspended or revoked if any false information is supplied toward securing the permit/any unauthorized changes are made to the site/any unauthorized changes are made in the installation of the system. Improvement Permit with plat valid without expiration. Improvement Permit with site plan valid for sixty months. Authorization to Construct is valid for a period equal to that of Improvement Permit – not to exceed sixty months.

Signed: X Matthew Cauthen date _____

Improvement Permit by: R. C. Moore date 10-7-98

Authorization to Construct by: R. C. Moore date 10-7-98

Installed by: David Yountz

Operation Permit by: Tracy C Ost date 3-8-99

Existing System Inspection by: _____ date _____

HEALTH DEPT. COPY: WHITE INSPECTION COPY (FINAL): GREEN OWNER COPY (FINAL): YELLOW INSPECTION COPY (INITIAL): PINK OWNER COPY (INITIAL): GOLD