IREDELL COUNTY HEALTH DEPARTMENT

STATESVILLE 704-878-5305 MOORESVILLE 704-664-5281

IMPROVEMENT PERMIT / AUTHORIZATION TO CONSTRUCT / OPERATION PERMIT / EXISTING SYSTEM INSPECTION

PERMIT# REPAIR PIN# DATE 2-25-00

OWNER OR CONTRACTOR KATHY C. NUNEZ PHONE: Business 872-4078 Home 876-2236

ADDRESS 154 TOM ROAD, STATESVILLE, NC 28625

LOCATION US 21 N, TL JENNINGS RD, TL GETHSEMANE RD, TR TOM ROAD, 0.2 MILE ON RIGHT

SUBDIVISION _____ BLOCK / SECTION _____ LOT _____ LOT AREA AMPLE ~2AC. SITE CLASS. PS DESIGN FLOW 360 L.T.A.R. EXISTING

Septic Tank: ~~EXISTING~~ Gallons; STB _____ Date _____

Pump Tank: _____ Gallons; PT _____ Date _____

Pump Make: _____ Model _____ Serial No. _____

Nitrification Field: No Fields 1 Square Feet 390 Linear Feet 130'

No Lines ONE Trench Width 36" Max Trench Bottom Depth 36" Gravel Depth 18"

☒ New System ☒ Repair System Type: I, (II), III, IV, V, VI

System Description: CONV. GRAVITY

Repair System Description: CONVENTIONAL GRAVITY

Maintenance Agreement Required: ☐ Yes ☒ No

☐ Slab ☐ Crawl Space ☐ Basement w/plumbing ☐ Basement wo/plumbing

☐ House/Mod. Home No. Bedrooms 3

☒ Mobile Home No. Bathrooms 2

☐ Business No. Employees _____

☐ Other _____


Water Supply: ☒ Individual ☐ Public ☐ Community

WELL

Comments:/Conditions: ① INSTALL NEW 3'x130' DRAINLINE USING 18" STONE ON CONTOUR AS FLAGGED INTERSECTING EXISTING DRAINLINES ② THIS PERMIT SERVES AS NOTICE OF VIOLATION - SYSTEM TO BE REPAIRED BY 3-30-00

Comments:/Conditions:

INITIAL SITE SKETCH

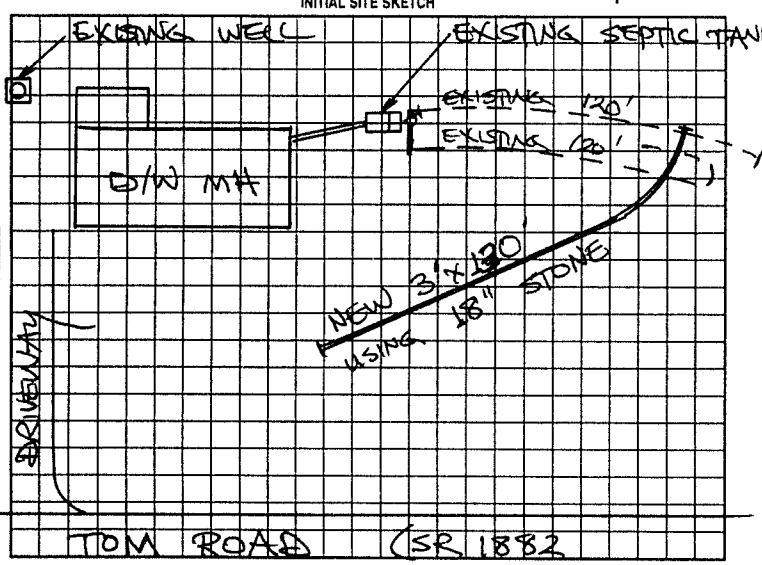

AS BUILT SKETCH

SYSTEM REPAIRED ACCORDING TO INITIAL SITE SKETCH

Permit can be suspended or revoked if any false information is supplied toward securing the permit/any unauthorized changes are made to the site/any unauthorized changes are made in the installation of the system. Improvement Permit with plat valid without expiration. Improvement Permit with site plan valid for sixty months. Authorization to Construct is valid for a period equal to that of Improvement Permit – not to exceed sixty months.

Signed: X Kathy C Nunez date 2/25/00 Installed by: A-1 BACKHOE

Improvement Permit by: STEVE HEDRICK date 2-25-00 Operation Permit by: STEVE HEDRICK date 3-13-00

Authorization to Construct by: STEVE HEDRICK date 2-25-00 Existing System Inspection by: _____ date _____

HEALTH DEPT. COPY. WHITE OWNER COPY (FINAL). YELLOW OWNER COPY (INITIAL). PINK