IREDELL COUNTY HEALTH DEPARTMENT - *ENVIRONMENTAL HEALTH* ☑ STATESVILLE OFFICE 704-878-5305 ☐ MOORESVILLE OFFICE 704-664-5281

IMPROVEMENT PERMIT / AUTHORIZATION TO CONSTRUCT / OPERATION PERMIT / EXISTING SYSTEM INSPECTION

PERMIT # 173422 PIN # 4840354056 DATE 6-27-12

OWNER Joel Williams APPLICANT: Billy Little PHONE: Home/Cell # 704-880-3068 Business # N/A

SITE ADDRESS 326 Gethsemane Rd. OWNER / APPLICANT ADDRESS 1014 Peath Rd. Troutman NC

SITE DIRECTIONS Hwy 77 N to Tomlin Mill exit; L on Tomlin Mill; R on Jennings; L on Gethsemane, Property on Right

SUBDIVISION N/A BLOCK / SECTION N/A LOT # N/A LOT AREA 7.56 DESIGN FLOW 480 gpd L.T.A.R. 0.4

Septic Tank 1000 Gallons: STB 1012 Date 5-21-94

Pump Tank ____ Gallons: P T ____ Date ____

Pump Make ____ Model ____ Serial # ____

No. Nitrification Fields: 1 No. Lines 4 Linear Feet 400

Trench Width 36" Max. Trench Bottom Depth 36" Gravel Depth 12"

☐ New System ☐ Repair ☐ Expansion System Type I (II) III IV V VI

System Description: Conventional gravity

Repair System Description: Conventional gravity

Maintenance Agreement Required ☐ YES ☑ NO

☑ GRAVITY ☐ PRESSURE

☑ Residence No. Bedrooms 4

☐ Business No. Persons ____

☐ Other No. Employees ____

☐ Slab ☐ Crawl Space

☑ Basement w/plumbing ☐ Basement w/o plumbing


Water Supply: ☐ Private ☑ Public ☐ Community

Comments / Conditions

- There was an excessive amount of fill over part of the nitrification field; There was mulch over entire septic tank PIL 957'

INITIAL SITE SKETCH

AS BUILT SKETCH

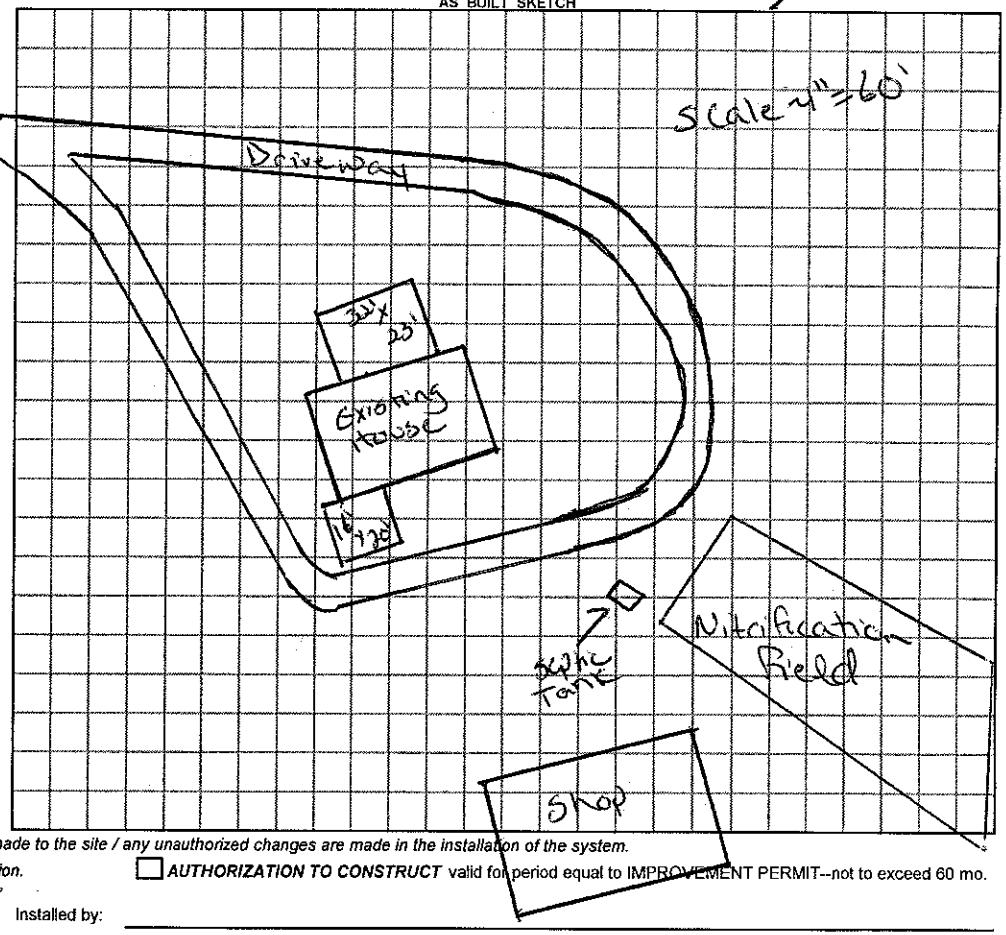

Permit can be suspended or revoked if any false information is supplied toward securing the permit / any unauthorized changes are made to the site / any unauthorized changes are made in the installation of the system.

☐ ***IMPROVEMENT PERMIT*** *with plat valid without expiration.* ☐ ***IMPROVEMENT PERMIT*** *with plat valid without expiration.* ***site plan valid 60 mo.*** ☐ ***AUTHORIZATION TO CONSTRUCT*** valid for period equal to IMPROVEMENT PERMIT--not to exceed 60 mo.

Owner / Applicant Signature: ____ Date ____ Installed by: ____

IMPROVEMENT PERMIT by: ____ ***REHS*** Date ____ OPERATION PERMIT by: ____ ***REHS*** Date ____

AUTHORIZATION TO CONSTRUCT by: ____ ***REHS*** Date ____ Existing System Inspected by: Justin Rendleman ***REHS*** Date 6-27-12

YOU SHOULD CONTACT A LOCATOR SERVICE PRIOR TO ANY EXCAVATION

White Copy – Environmental Health YELLOW COPY (Final) Owner / Applicant PINK COPY (Initial) Owner / Applicant