IREDELL COUNTY HEALTH DEPARTMENT

STATESVILLE 704-878-5305 (C1) MOORESVILLE 704-664-5281

IMPROVEMENT PERMIT / AUTHORIZATION TO CONSTRUCT / OPERATION PERMIT / EXISTING SYSTEM INSPECTION

PERMIT# 106690 PIN# 4840-62-0809 DATE 6-25-02

OWNER OR CONTRACTOR SUZANNE & WILLIAM GATTON PHONE Business _____ Home 704-876-0582

ADDRESS 159 GETHSEMANE ROAD OLIN NC 28660

LOCATION US 21 N, TL JENNINGS RD, TL GETHSEMANE RD, 0.25 MILE ON LEFT AT # 159

SUBDIVISION _____ BLOCK / SECTION _____ LOT _____ LOT AREA 1.05 AC (BT) SITE CLASS PS DESIGN FLOW 360 L.T.A.R. 0.35 GPD/FT²

Septic Tank: 1000 Gallons; STB 1012 Date 2-18-02

Pump Tank: _____ Gallons; PT _____ Date _____

Pump Make: _____ Model _____ Serial No. _____

Nitrification Field: No Fields 1 Square Feet 540 Linear Feet 180

No Lines THREE Trench Width 36" Max Trench Bottom Depth 36" Gravel Depth 12"

☐ New System ☐ Repair System Type: I II III IV V VI

System Description: CONVENTIONAL GRAVITY

Repair System Description: 25% REDUCTION, PUMP

Maintenance Agreement Required: ☐ Yes ☐ No

☐ House/Mod. Home ☐ Mobile Home ☐ Business ☐ Other ADDITION

No. Bedrooms 3 No. Bathrooms 2 No. Employees _____


☐ Slab ☐ Crawl Space ☐ Basement w/plumbing ☐ Basement wo/plumbing

Water Supply: ☐ Individual ☐ Public ☐ Community WELL


Comments/Conditions: ① EXPAND SYSTEM AS SHOWN USING 5 DROP BOXES FOR SEPTIC DISTRIBUTION. ② ABANDON EXISTING SEPTIC TANK BY CRUSHING & FILLING WITH CLAY SOIL

Comments/Conditions: SEPTIC TANK WITH MARKER INSTALLED USING "PAYLOK" FILTER

INITIAL SITE SKETCH

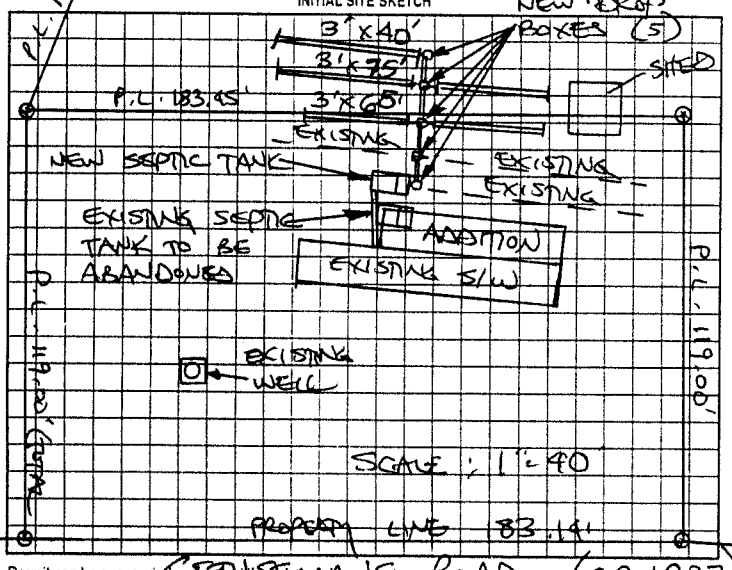

AS BUILT SKETCH

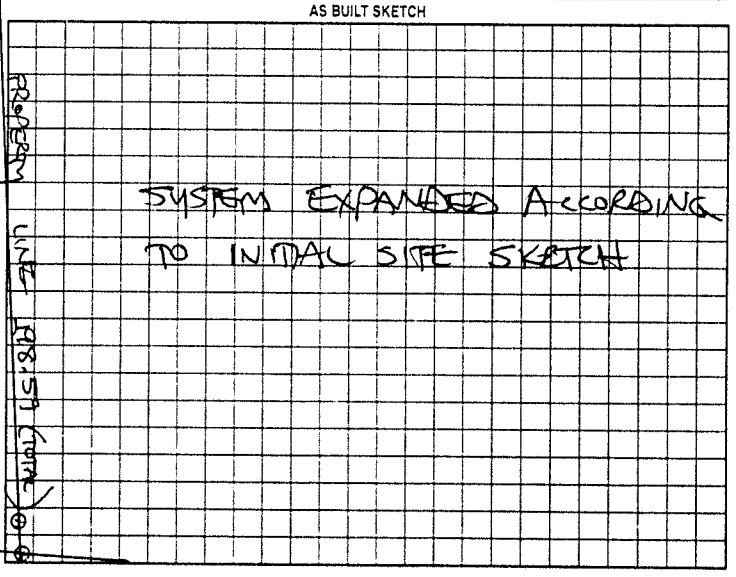

Permit can be suspended or revoked and fee not refunded if system is supplied water securing the permit or if unauthorized changes are made to the site any unauthorized changes are made in the installation of the system. Improvement Permit with plat valid without expiration. Improvement Permit with site plan valid for sixty months. Authorization to Construct is valid for a period equal to that of Improvement Permit – not to exceed sixty months

Signed: William E Gatton date 6-25-02 Installed by A-1 BACKHOE

Improvement Permit by: STEVE HEDRICK date 6-25-02 Operation Permit by: STEVE HEDRICK date 6-26-02

Authorization to Construct by: STEVE HEDRICK date 6-25-02 Existing System Inspection by: _____ date _____

HEALTH DEPT COPY WHITE OWNER COPY (FINAL) YELLOW OWNER COPY (INITIAL) PINK