# IREDELL COUNTY HEALTH DEPARTMENT

STATESVILLE 704-878-5305 MOORESVILLE 704-664-5281

## IMPROVEMENT PERMIT / CERTIFICATE OF COMPLETION / OPERATION PERMIT / EXISTING SYSTEM INSPECTION

PROPERTY DESCRIPTION NO. 17454 DATE 11/17/93 TAX MAP NO. Ptof. 13M-A-33 Watershed: ☐ Yes ☒ No

OWNER OR CONTRACTOR SUZANNE SHAVER PHONE: Business Home 546-7959

ADDRESS RT. 2, Box 143-A, HARMONY, NC 28634

LOCATION US 21 N, TL JENNINGS ROAD, TL GETHSEMANE RD, ~0.25 MILE ON L

SUBDIVISION BLOCK / SECTION LOT LOT AREA ~119 X 183' SITE CLASS. PS DESIGN FLOW 240 L.T.A.R. 0.35 GAD/FT²

Septic Tank: 1000 Gallons; STB 358 Date 10/15/93

Pump Tank: Gallons; PT Date

Pump Make: Model Serial No.

Nitrification Field: No Fields 1 Square Feet 690 Linear Feet 230

No Lines 3 Trench Width 36" Max Trench Bottom Depth 36"

☒ New System ☐ Repair System Type: I, II, III, IV, V, VI

System Description: CONV. GRAVITY

Repair System Description: CONV. GRAVITY

Maintenance Agreement Required: ☐ Yes ☒ No

Gravel Depth 12"

☐ House/Mod. Home ☑ Mobile Home ☐ Business ☐ Other

No. Bedrooms 2 No. Bathrooms 2 No. Employees


☐ Slab ☒ Crawl Space ☐ Basement w/plumbing ☐ Basement wo/plumbing

Water Supply: ☑ Individual ☐ Community ☐ Public WELL

Comments: (1) KEEP SYSTEM MINIMUM 5' FROM MH, 10' FROM PROPERTY LINE, MAX. FEASIBLE DISTANCE FROM WELL BUT NOT LESS THAN 50' (2) INSTALL LINES ON CONTOUR NO DEEPER THAN 36", 9' APART ON CENTER

Comments:

INITIAL SITE SKETCH

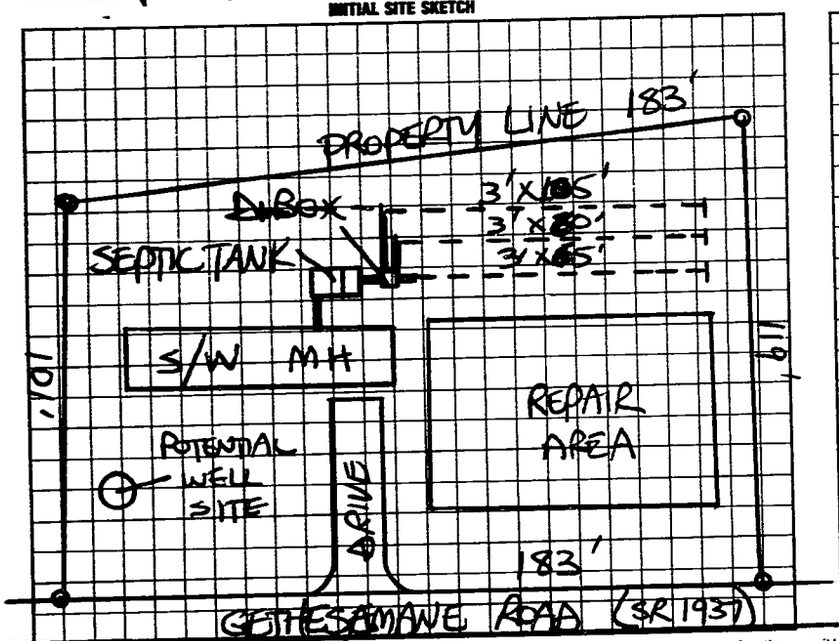


AS BUILT SKETCH

SYSTEM INSTALLED ACCORDING TO INITIAL SITE SKETCH

I understand that this permit can be suspended or revoked if any false information is supplied toward securing the permit/any unauthorized changes are made to the site/any unauthorized changes are made in the installation of the system. Improvement Permit is valid for 60 months from date of issuance.

Signed: [signature]

Improvement Permit by: STEVE HEDRICK date 11/17/93

Existing System Inspection by: date

Installed by: A-1 BACKHOE

Certificate of Completion by: STEVE HEDRICK date 11/24/93

Operation Permit by: date

HEALTH DEPT. COPY: WHITE INSPECTION COPY (FINAL): GREEN OWNER COPY (FINAL): YELLOW INSPECTION COPY (INITIAL): PINK OWNER COPY (INITIAL): GOLD