IREDELL COUNTY HEALTH DEPARTMENT

STATESVILLE 704-878-5305 MOORESVILLE 704-664-5281

IMPROVEMENT PERMIT / CERTIFICATE OF COMPLETION / OPERATION PERMIT / EXISTING SYSTEM INSPECTION

PROPERTY DESCRIPTION NO. 069196 DATE 9-8-97 TAX MAP NO. 4840535473 Watershed: ☐ Yes ☑ No

OWNER OR CONTRACTOR DEWEY C. MC COY PHONE: Business Home 876-4892

ADDRESS 125 MONICA LANE, OLIN NC 28660

LOCATION US 21 N, TL JENNINGS ROAD, TL SEDGEMANE ROAD 0.3 MILE ON LEFT

SUBDIVISION BLOCK / SECTION LOT LOT AREA 2.019 ACRE SITE CLASS. PSI DESIGN FLOW 360 L.T.A.R. 0.33 GPD/FT²

Septic Tank: 1000 Gallons; STB 1017 Date 8-24-97

Pump Tank: Gallons; PT Date

Pump Make: Model Serial No.

Nitrification Field: No Fields 1 Square Feet 1080 Linear Feet 360

No Lines FOUR Trench Width 36" Max Trench Bottom Depth 36" Gravel Depth 12"

☑ New System ☐ Repair System Type: I, II, III, IV, V, VI

System Description: CONVENTIONAL GRAVITY

Repair System Description: CONV. GRAVITY

Maintenance Agreement Required: ☐ Yes ☑ No

☐ House/Mod. Home No. Bedrooms 3

☑ Mobile Home No. Bathrooms 2

☐ Business No. Employees

☐ Other


☐ Slab ☑ Crawl Space ☐ Basement w/plumbing ☐ Basement wo/plumbing

Water Supply: ☑ Individual ☐ Community ☐ Public WELL


Comments: ① KEEP SYSTEM MINIMUM 100' FROM WELL. ② INSTALL LINES ON CONTOUR AS FLAGGED ON SITE

Comments: Added 45ft of drain line Due to Rock Depth P.L 595.83'

INITIAL SITE SKETCH

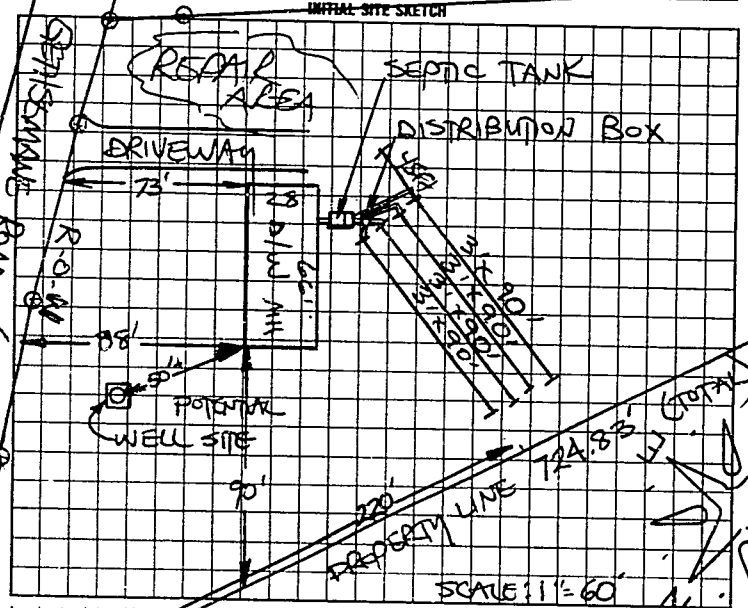

AS BUILT SKETCH

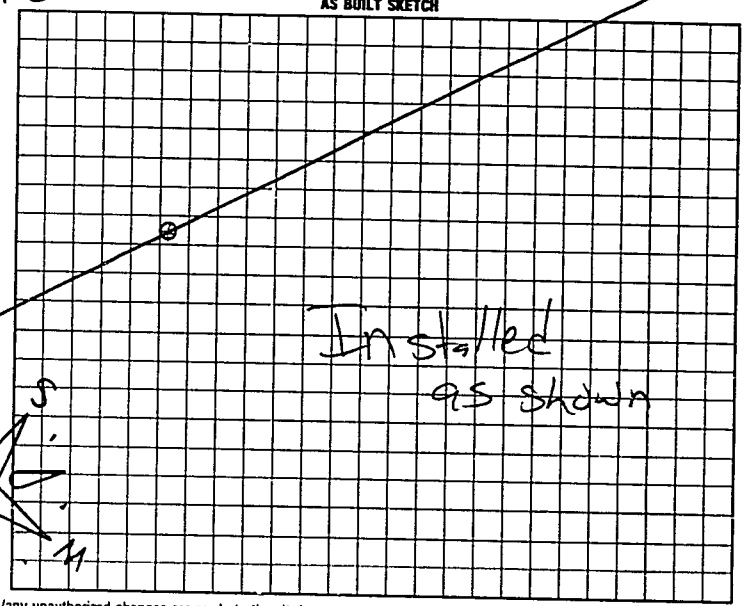

I understand that this permit can be suspended or revoked if any false information is supplied toward securing the permit/any unauthorized changes are made to the site/any unauthorized changes are made in the installation of the system. Improvement Permit is valid for 60 months from date of issuance. AUTHORIZATION TO CONSTRUCT IS VALID FOR 60 MONTHS FROM DATE OF ISSUANCE

Signed: Dewey McCoy

Improvement Permit by: STEVE HEDRICK date 9-8-97

Existing System Inspection by: STEVE HEDRICK date 9-8-97

Installed by: Don Emes

Certificate of Completion by: date

Operation Permit by: Mark C. Osf date 10-13-97

HEALTH DEPT. COPY: WHITE INSPECTION COPY (FINAL): GREEN OWNER COPY (FINAL): YELLOW INSPECTION COPY (INITIAL): PINK OWNER COPY (INITIAL): GOLD