IREDELL COUNTY HEALTH DEPARTMENT

STATESVILLE 704-878-5305 MOORESVILLE 704-664-5281

IMPROVEMENT PERMIT / CERTIFICATE OF COMPLETION / OPERATION PERMIT / EXISTING SYSTEM INSPECTION

PROPERTY DESCRIPTION NO. 067672 DATE 8-4-97 TAX MAP NO. 4840612918 (PT) Watershed: ☐ Yes ☒ No

OWNER OR CONTRACTOR R. E. GATTON PHONE: Business 873-6967 Home 876-2890

ADDRESS 125 GETHSEMANE ROAD, OLIN NC 28660

LOCATION US 21 N, TL JENNINGS ROAD, TL GETHSEMANE ROAD, ON LEFT BEHIND BOX #125

SUBDIVISION _____ BLOCK / SECTION _____ LOT _____ LOT AREA 0.44 AC SITE CLASS PS DESIGN FLOW 240 L.T.A.R. 0.33 GPD/FT²

Septic Tank: 1000 Gallons; STB 1012 Date 10-16-98
Pump Tank: _____ Gallons; PT _____ Date _____
Pump Make: _____ Model _____ Serial No. _____
Nitrification Field: No Fields 1 Square Feet 720 Linear Feet 240
No Lines FOUR Trench Width 36" Max Trench Bottom Depth 36" Gravel Depth 12"

☒ New System ☐ Repair System Type: I, II, III, IV, V, VI
System Description: CONVENTIONAL GRAVITY
Repair System Description: CHAMBERED GRAVITY
Maintenance Agreement Required: ☐ Yes ☒ No
☐ Slab ☒ Crawl Space ☐ Basement w/plumbing ☐ Basement wo/plumbing


☐ House/Mod. Home No. Bedrooms 2
☒ Mobile Home No. Bathrooms 2
☐ Business No. Employees _____
☐ Other _____

Water Supply:
☐ Individual
☐ Community
☒ Public

Comments:

Comments:

INITIAL SITE SKETCH SCALE: 1" = 40'

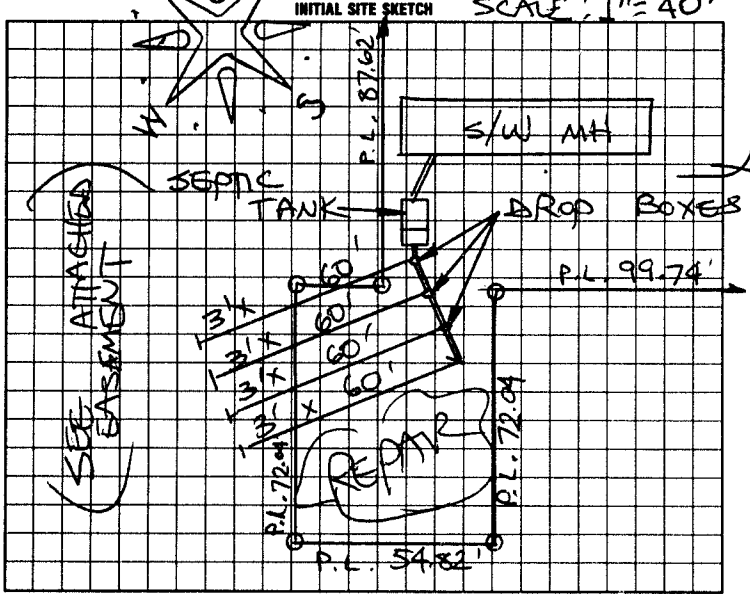

AS BUILT SKETCH

SYSTEM INSTALLED ACCORDING TO INITIAL SITE SKETCH

I understand that this permit can be suspended or revoked if any false information is supplied toward securing the permit/any unauthorized changes are made to the site/any unauthorized changes are made in the installation of the system. Improvement Permit is valid for 60 months from date of issuance. AUTHORIZATION TO CONSTRUCT IS VALID FOR 60 MONTHS FROM DATE OF ISSUANCE

Signed: R. E. Gatton Installed by: KENNY PEARSON

Improvement Permit by: STEVE HEDRICK date 8-4-97

~~Existing System Inspection~~ AUTH TO CONST by: STEVE HEDRICK date 8-4-97

~~Certificate of Completion~~ by: _____ date _____

Operation Permit by: STEVE HEDRICK date 1-7-99

HEALTH DEPT. COPY: WHITE INSPECTION COPY (FINAL): GREEN OWNER COPY (FINAL): YELLOW INSPECTION COPY (INITIAL): PINK OWNER COPY (INITIAL): GOLD