IREDELL COUNTY HEALTH DEPARTMENT

THIS PERMIT VOIDS PREVIOUS ISSUED 7-1-98

STATESVILLE 704-878-5305 · MOORESVILLE 704-664-5281

IMPROVEMENT PERMIT / AUTHORIZATION TO CONSTRUCT / OPERATION PERMIT / EXISTING SYSTEM INSPECTION

PERMIT# 2431 PIN# 13L-A-33 (PART OF)

OWNER OR CONTRACTOR STANLEY WATKINS PHONE: Business _____ DATE 7-1-98

ADDRESS 2058 JENNINGS ROAD, OLIN, NC 28660 Home 876-6862

LOCATION US21 N, TL JENNINGS ROAD, LOT ON LEFT ~1.0 MILE PAST GETHSEMANE ROAD

SUBDIVISION _____ BLOCK / SECTION _____ LOT _____ LOT AREA ACREAGE SITE CLASS. PS DESIGN FLOW 360 L.T.A.R. 0.35 GPD/FT2

Septic Tank: 1000 Gallons; STB 1012 Date 5-4-98

Pump Tank: _____ Gallons; PT _____ Date _____

Pump Make: _____ Model _____ Serial No. _____

Nitrification Field: No Fields 1 Square Feet 1035 Linear Feet 345

No Lines THREE Trench Width 36" Max Trench Bottom Depth 30" Gravel Depth 12"

☑ New System ☐ Repair System Type: I, II, III, IV, V, VI

System Description: CONVENTIONAL GRAVITY

Repair System Description: CONV. GRAV / PUMP

Maintenance Agreement Required: ☐ Yes ☑ No

☑ House/Mod. Home ☐ Mobile Home ☐ Business ☐ Other

No. Bedrooms 3 No. Bathrooms 2 No. Employees _____


☐ Slab ☐ Crawl Space ☑ Basement w/plumbing ☐ Basement wo/plumbing

Water Supply: ☐ Individual ☑ Public ☐ Community


Comments:/Conditions: THIS PERMIT VOIDS PREVIOUS ISSUED 8-12-96

Comments:/Conditions:

INITIAL SITE SKETCH SCALE: 1" = 40'

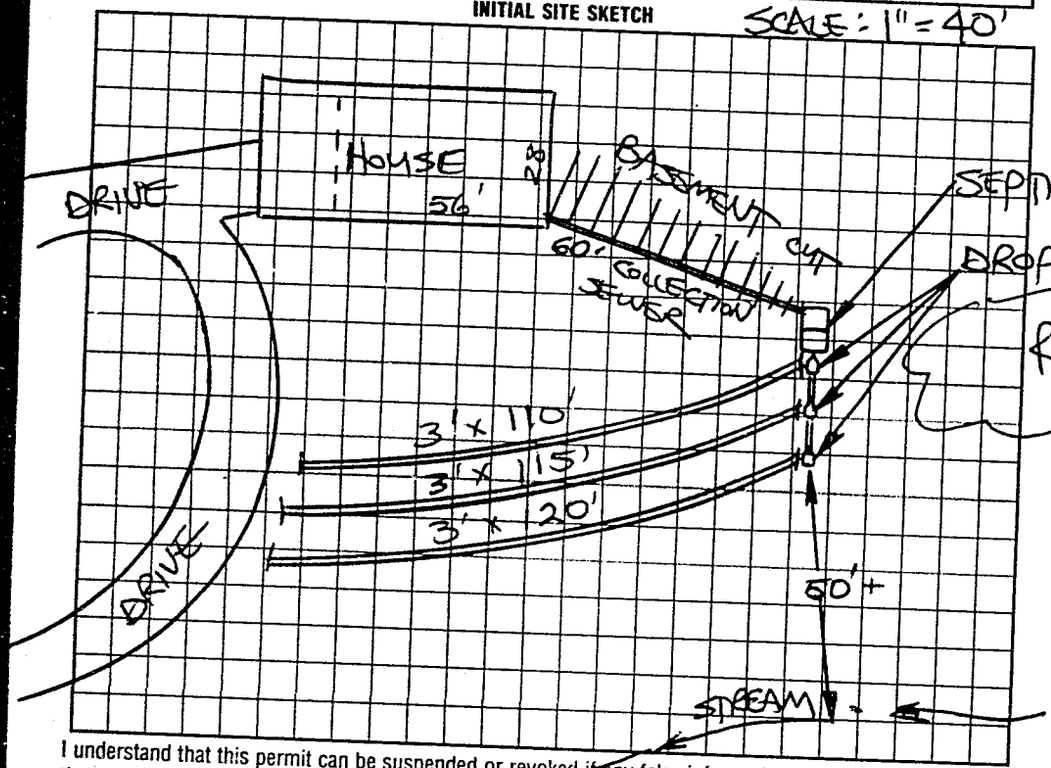

AS BUILT SKETCH

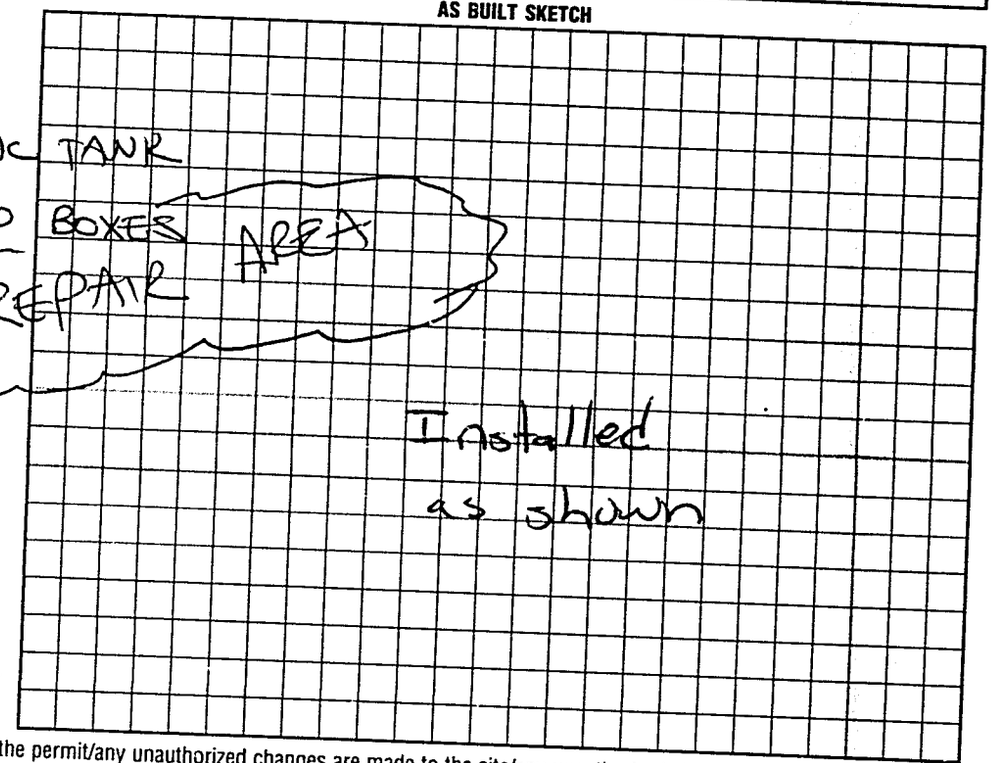

I understand that this permit can be suspended or revoked if any false information is supplied toward securing the permit/any unauthorized changes are made to the site/any unauthorized changes are made in the installation of the system. Improvement Permit with plat valid without expiration. Improvement Permit with site plan valid for sixty months. Authorization to Construct is valid for a period equal to that of Improvement Permit – not to exceed sixty months.

Signed: X Stanley G. Watkins date 7-1-98

Improvement Permit by: STEVE HEDRICK date 7-1-98

Authorization to Construct by: STEVE HEDRICK date 7-1-98

Installed by: Kenny Madison

Operation Permit by: Mat Collins date 7-9-98

Existing System Inspection by: _____ date _____

HEALTH DEPT. COPY: WHITE · INSPECTION COPY (FINAL): GREEN · OWNER COPY (FINAL): YELLOW · INSPECTION COPY (INITIAL): PINK · OWNER COPY (INITIAL): GOLD