IREDELL COUNTY HEALTH DEPARTMENT

Statesville Office (704) 878-5305 Mooresville Office (704) 660-3625 PERMIT # 216568

IMPROVEMENT PERMIT / AUTHORIZATION TO CONSTRUCT / OPERATION PERMIT / EXISTING SYSTEM

PIN # 4840774996.147

APPLICANT: Eric Ward (Freedom Homes) APPLICANT ADDRESS: 1124 Charlotte Hwy

SITE ADDRESS: 147 Monica Dr Olin NC PHONE: 704-528-7960 ALT. PHONE: N/A


SITE DIRECTIONS: 21 N T/L Jennings Rd T/L Monica Dr Lot on Left

SUBDIVISION: Rolling Hills MHP SECTION: N/A LOT # 147 LOT AREA: 16.74ac DESIGN FLOW: 240 L.T.A.R.: Ex


Septic Tank	Ex	(gal)	STB		Date	☐ New System	☐ Repair	☐ Expansion	System Type: I	☒ II	III IV V VI	☑ Residence	No. Bedrooms	2	Water Supply
Pump Tank		(gal)	PT		Date	System Description:	Existing					☐ Business	No. Persons	4	☐ Private
Pump Make		Model			Serial #	Repair System Description:						☐ Other	No. Employees		☒ Public
# Nitrification Fields	Ex	# Lines	Ex		Linear Ft: Ex	Maintenance Agreement Required:	☐ YES	☒ NO				☐ Slab	☒ Crawl Space		☐ Community
Trench Width	Ex	Max. Trench Bottom Depth	Ex		Gravel Depth Ex		☑ GRAVITY	☐ PRESSURE				☐ Basement w/plumbing		☐ Basement w/o plumbing	

Comments / Conditions: All building foundations must be 35' from any part of STS.

INITIAL SITE SKETCH

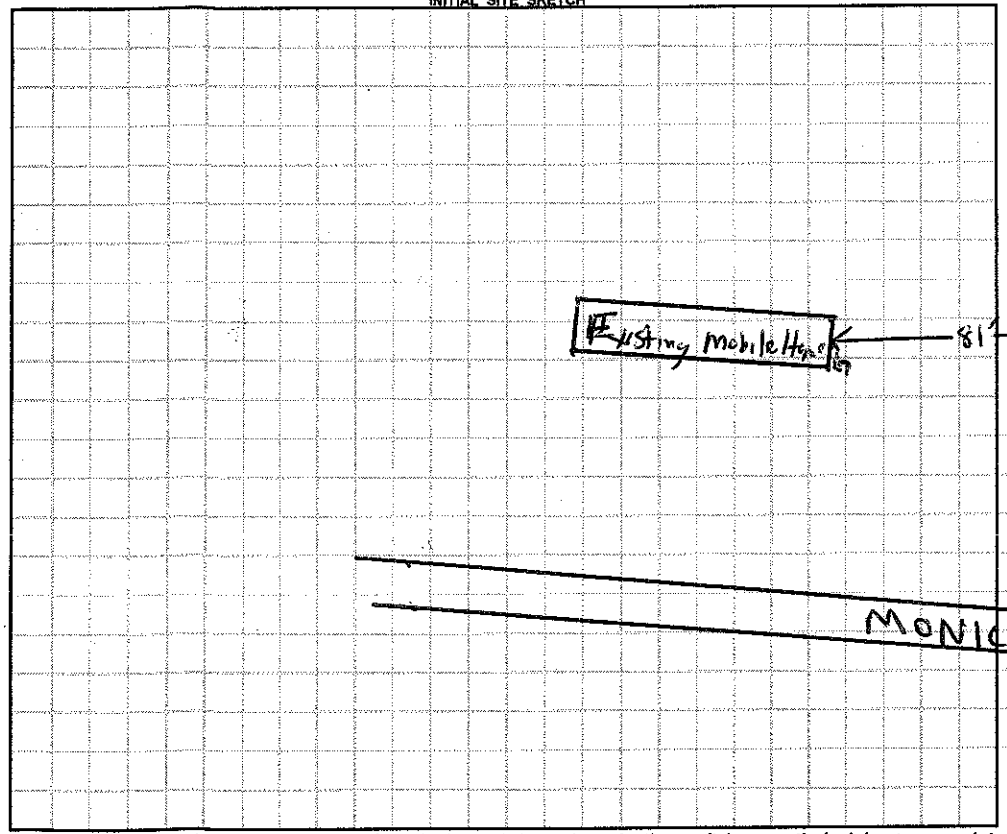

AS BUILT SKETCH

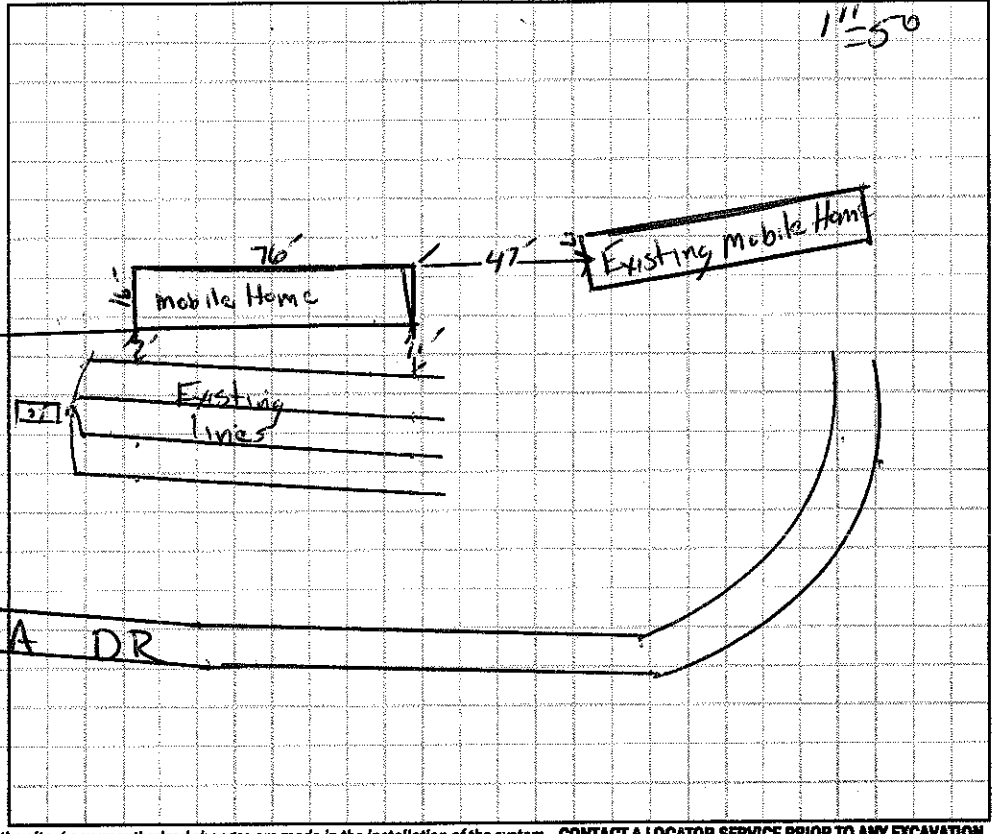

Permit can be suspended or revoked if any false information is supplied toward securing the permit / any unauthorized changes are made to the site / any unauthorized changes are made in the installation of the system. **CONTACT A LOCATOR SERVICE PRIOR TO ANY EXCAVATION**

☐ **IMPROVEMENT PERMIT** *with plat valid without expiration.* ☐ **IMPROVEMENT PERMIT** *with site plan valid for 60 mos.* ☐ **AUTHORIZATION TO CONSTRUCT** *valid for period equal to IMPROVEMENT PERMIT--not to exceed 60 mo.*

Owner / Applicant Signature: [signature] Date: 2/25/16 Installed by:

IMPROVEMENT PERMIT by: Date: OPERATION PERMIT by: Date:

AUTHORIZATION TO CONSTRUCT by: Date: Existing System Inspected by: [signature] Date: 02/25/16

Health Dept. Copy - WHITE Applicant (Final Approval) - YELLOW Applicant (Conditional Approval) - PINK