IREDELL COUNTY HEALTH DEPARTMENT / Authorization to Construct

STATESVILLE 704-878-5305 MOORESVILLE 704-664-5281

IMPROVEMENT PERMIT / ~~CERTIFICATE OF COMPLETION~~ / OPERATION PERMIT / EXISTING SYSTEM INSPECTION

PROPERTY DESCRIPTION NO. 24276 DATE 7/31/96 TAX MAP NO. 13L A 67 Watershed: ☐ Yes ☒ No

OWNER OR CONTRACTOR David Millsaps

ADDRESS 1124 Radio Rd. Statesville, NC. 28677 PHONE: Business 873-1331 Home

LOCATION I-77 N exit 59 TL Tomlin Mill TR Jennings Rd. TL Monica to 1st MH on (R)

SUBDIVISION Rolling Hills BLOCK / SECTION II LOT 1 LOT AREA .399 Ac SITE CLASS. PS DESIGN FLOW 360 L.T.A.R. .35

Septic Tank: 1000 Gallons; STB 1012 Date 7-12-97

Pump Tank: Gallons; PT Date

Pump Make: Model Serial No.

Nitrification Field: No Fields 1 Square Feet 1028 Linear Feet 256*

No Lines 3 Trench Width 36" Max Trench Bottom Depth 36" Gravel Depth SAND.

☒ New System ☐ Repair System Type: I. II. (III) IV. V. VI

System Description: * Div - Ch Plastic

Repair System Description: 16" Panel

Maintenance Agreement Required: ☐ Yes ☒ No

☐ House/Mod. Home ☒ Mobile Home ☐ Business ☐ Other

No. Bedrooms 3 No. Bathrooms 2 No. Employees


☐ Slab ☒ Crawl Space ☐ Basement w/plumbing ☐ Basement wo/plumbing

Water Supply: ☐ Individual ☒ Community ☐ Public

Comments:

Comments:

INITIAL SITE SKETCH

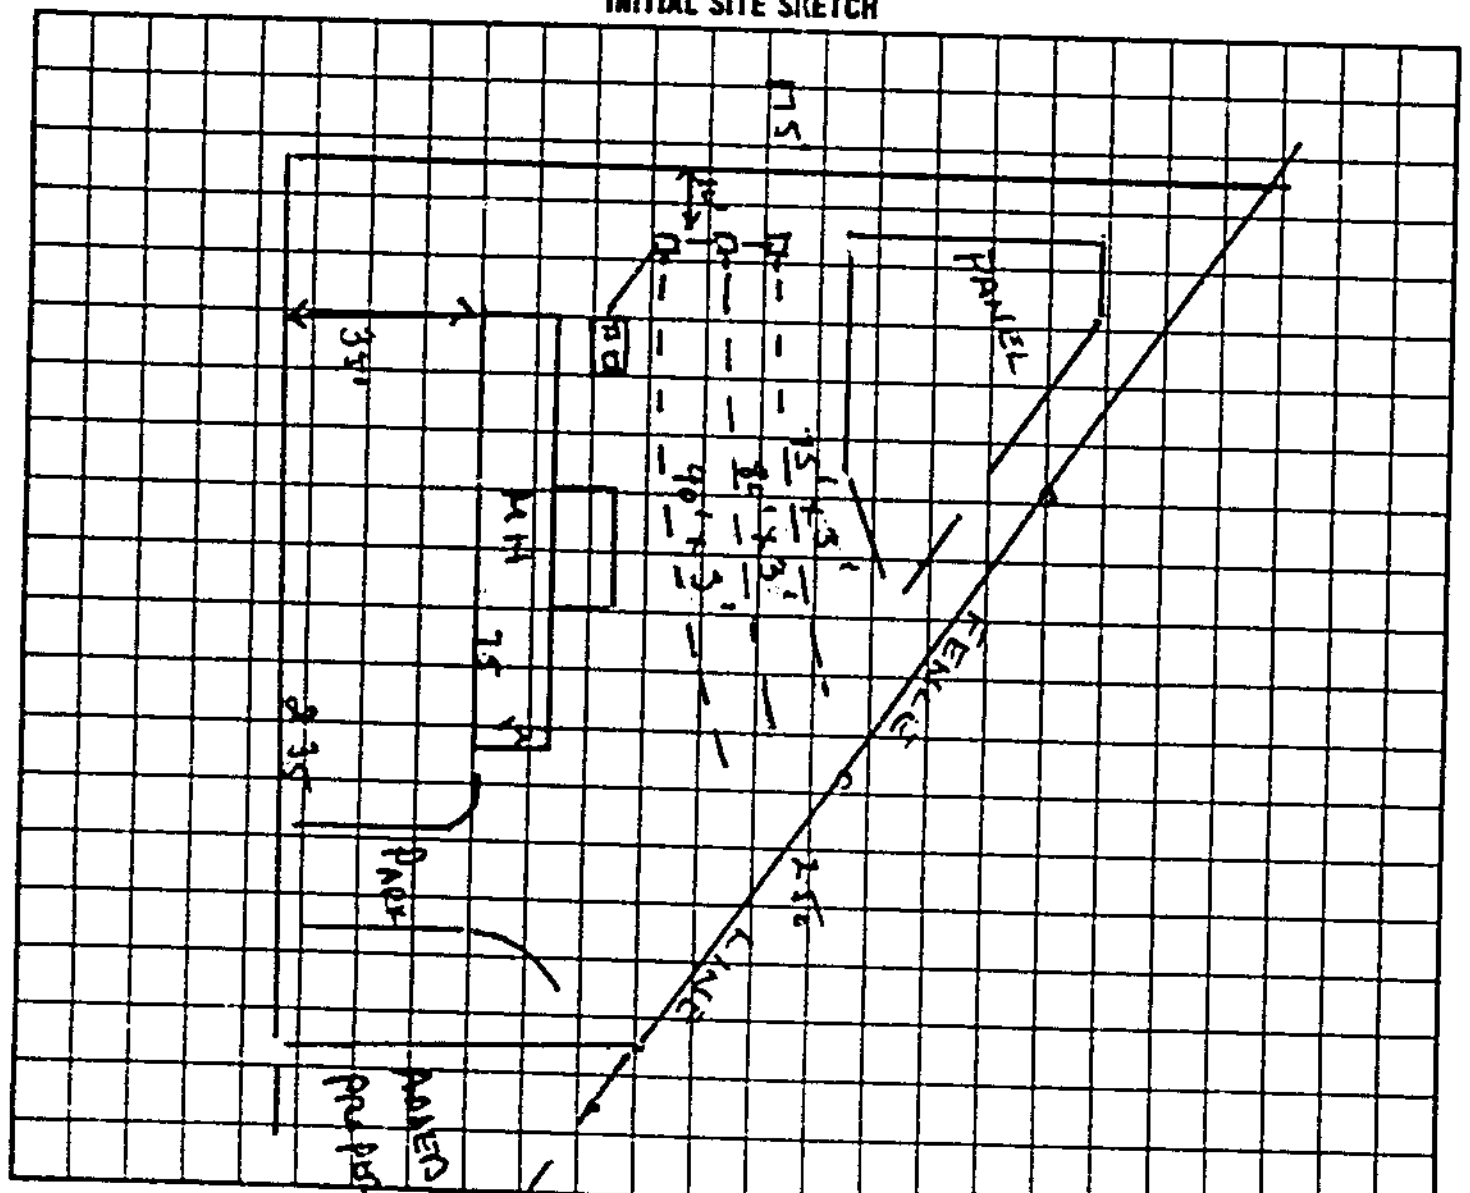

AS BUILT SKETCH

SYSTEM INSTALLED ACCORDING TO INITIAL SITE SKETCH

1" = 50'

I understand that this permit can be suspended or revoked if any false information is supplied toward securing the permit/any unauthorized changes are made to the site/any unauthorized changes are made in the installation of the system.

Authorization to Construct valid 60 months.

Signed: [signature]

Improvement Permit by: Wesley Sparks RS. date 8/1/96

Authorization to Construct / Existing System Inspection by: Wesley Sparks RS. date 8/1/96

Installed by: KENNY MADISON

Certificate of Completion by: date

Operation Permit by STEVE HEDRICK date 9-19-97

HEALTH DEPT COPY WHITE INSPECTION COPY (FINAL) GREEN OWNER COPY (FINAL) YELLOW INSPECTION COPY (INITIAL) PINK OWNER COPY (INITIAL) GOLD