IREDELL COUNTY HEALTH DEPARTMENT

Statesville Phone TR 3-7271 — Mooresville Phone NO 3-1271

PERMIT TO INSTALL SEPTIC TANK

Permit No. 165 — Permit Date April 3 1972

Owner Ray Lowe — Address Olin Rt 1

Installed By J. W. Jones Jr. — Address Mocksville Rt 5

Location of Property North of Statesville on left of Jennings Road


Hwy 13

Tank		Capacity		Length of Lines		Fixtures	
Block	( )	1000	(x)	225'	( )	No. of Baths	( )
Precast	(x)	1250	( )	250'	( )	Dishwasher	( )
		1500	( )	Other 5X112		Garbage Grdr.	( )
		Other				Other	

NOTIFY HEALTH DEPARTMENT AT LEAST EIGHT HOURS BEFORE TANK IS TO BE INSPECTED.

Final Inspection _____ 19__ — Approved ( ) Disapproved ( )

Remarks

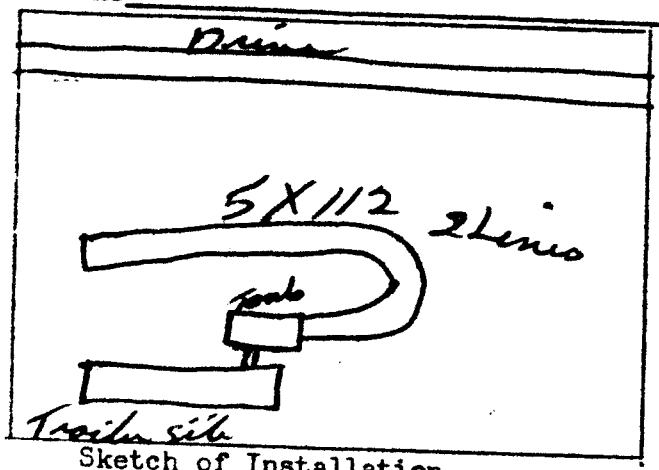

Sketch of Installation

Not checked

Sanitarian