IREDELL COUNTY HEALTH DEPARTMENT

Statesville Phone TR 3-7271 Mooresville Phone NO 3-1271

PERMIT TO INSTALL SEPTIC TANK

Permit No. 144 Permit Date _____ 19__

Owner Rex Lowe, Idledown Trailer Park Address Rt 1 Olin NC

Installed By J. W. Jones Address Mocksville NC


Location of Property Out Jennings Road # 1892
Trailer Park on left Lot # 9

Tank		Capacity		Length of Lines		Fixtures	
Block	( )	1000	(✓)	225'	(✓)	No. of Baths	( )
Precast	(✓)	1250	( )	250'	( )	Dishwasher	( )
		1500	( )	Other _____		Garbage Grdr.	( )
		Other _____				Other _____	

NOTIFY HEALTH DEPARTMENT AT LEAST EIGHT HOURS BEFORE TANK IS TO BE INSPECTED.

Final Inspection 3-15 1972 Approved (✓) Disapproved ( )

Remarks Approved Water System.

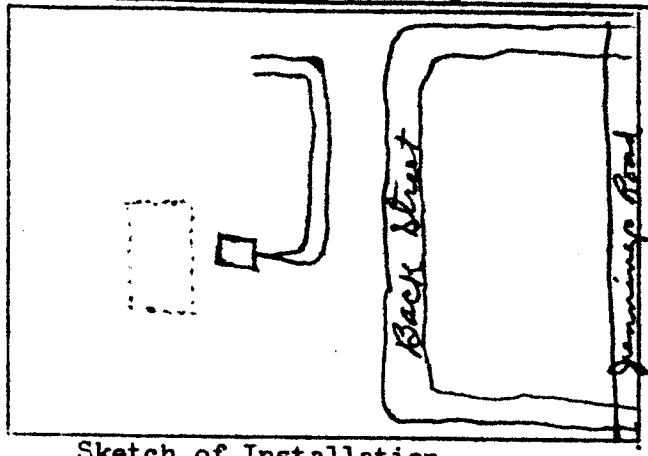

Sketch of Installation

E. A. Stevenson
Sanitarian