IREDELL COUNTY HEALTH DEPARTMENT

STATESVILLE 704-878-5305 MOORESVILLE 704-664-5281

IMPROVEMENT PERMIT / CERTIFICATE OF COMPLETION / OPERATION PERMIT / EXISTING SYSTEM INSPECTION

PROPERTY DESCRIPTION NO. R66627 DATE 5-28-97 TAX MAP NO. 4840806688 Watershed: ☐ Yes ☐ No

OWNER OR CONTRACTOR JOHNNY R. ELY PHONE: Business Home (910) 463-4072 (DISCONNECTED)

ADDRESS 1105 HENRY CRAWFIS ROAD, YADKINVILLE, NC 27055

LOCATION US 21 N, TL JENNINGS RD, TR OLIN ROAD, (SOUTH) 3RD DWELLING ON LEFT (B-9I-7)

SUBDIVISION _____ BLOCK / SECTION _____ LOT _____ LOT AREA LIMITED SITE CLASS PS DESIGN FLOW 240 L.T.A.R. EXISTING

Septic Tank: EXISTING Gallons; STB _____ Date _____

Pump Tank: _____ Gallons; PT _____ Date _____

Pump Make: _____ Model _____ Serial No. _____

Nitrification Field: No Fields ____ Square Feet _____ Linear Feet EXISTING

No Lines _____ Trench Width _____ Max Trench Bottom Depth _____ Gravel Depth _____

☐ New System ☐ Repair System Type: I (II) III, IV, V, VI

System Description: CONV. GRAVITY

Repair System Description: _____

Maintenance Agreement Required: ☐ Yes ☑ No

☐ Slab ☑ Crawl Space ☐ Basement w/plumbing ☐ Basement wo/plumbing

☐ House/Mod. Home No. Bedrooms 2

☑ Mobile Home No. Bathrooms 2

☐ Business No. Employees ____

☐ Other _____

Water Supply:

☑ Individual

☐ Community

☐ Public


WELL

Comments:

Comments: ① MH ON SITE AT TIME OF INSPECTION ② SYSTEM APPEARS TO BE UNDERSIZED BY TODAY'S STANDARDS

INITIAL SITE SKETCH

AS BUILT SKETCH

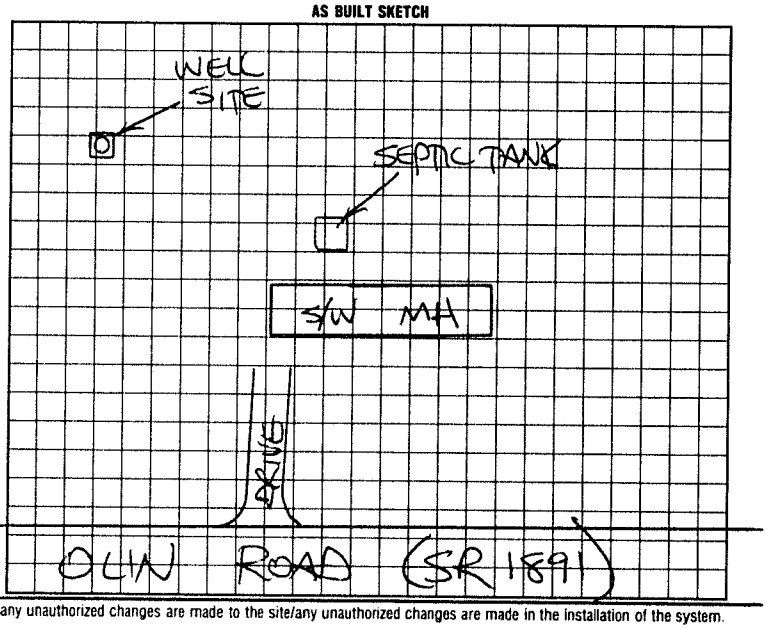

I understand that this permit can be suspended or revoked if any false information is supplied toward securing the permit/any unauthorized changes are made to the site/any unauthorized changes are made in the installation of the system. Improvement Permit is valid for 60 months from date of issuance.

Signed: _____

Improvement Permit by: _____ date _____

Existing System Inspection by: STEVE HEDRICK date 5-28-97

Installed by: _____

Certificate of Completion by: _____ date _____

Operation Permit by: _____ date _____

HEALTH DEPT. COPY: WHITE INSPECTION COPY (FINAL): GREEN OWNER COPY (FINAL): YELLOW INSPECTION COPY (INITIAL): PINK OWNER COPY (INITIAL): GOLD