See attached #165736, 3/16/11, for Pole Barn addition

IREDELL COUNTY HEALTH DEPARTMENT

STATESVILLE 704-878-5305 MOORESVILLE 704-664-5281

IMPROVEMENT PERMIT / AUTHORIZATION TO CONSTRUCT / OPERATION PERMIT / EXISTING SYSTEM INSPECTION

PERMIT# 124581 PIN# 4840-86-0742 DATE 11/15/04

OWNER OR CONTRACTOR WALLY EADES PHONE: Business (704) 838-3360 Home

ADDRESS 2143 JENNINGS RD. OLIN NC 28660

LOCATION I-77 N TL TOMLIN MILL RD TR JENNINGS 2.8 MILES TL CLAYBROOK AT END ON LEFT

SUBDIVISION BLOCK / SECTION LOT LOT AREA 6.5 SITE CLASS. PS DESIGN FLOW 480 L.T.A.R. 0.30 gpd/ft²

Septic Tank: 1000 Gallons; STB 1007 Date 4-28-05
Pump Tank: Gallons; PT Date
Pump Make: Model Serial No.
Nitrification Field: No Fields 1 Square Feet 1600 Linear Feet 400
No Lines 5 Trench Width 36" Max Trench Bottom Depth 36" Gravel Depth N/A

☑ New System ☐ Repair System Type: I, II, III, IV, V, VI
System Description: GRAVITY 25% REDUCTION
Repair System Description: PUMP 25% REDUCTION
Maintenance Agreement Required: ☐ Yes ☑ No

☑ House/Mod. Home No. Bedrooms 4
☐ Mobile Home No. Bathrooms
☐ Business No. Employees
☐ Other
☐ Slab ☑ Crawl Space ☐ Basement w/plumbing ☐ Basement wo/plumbing


Water Supply: ☐ Individual ☐ Public ☑ Community

Comments/Conditions: ① INSTALL ON CONTOUR ② MAINTAIN ALL SETBACKS

Comments/Conditions: ZABEL FILTER W/ MARKER ON TANK
QUICK 4 CHAMBERS (STD-W 1H10)

INITIAL SITE SKETCH

* 1" = 60'

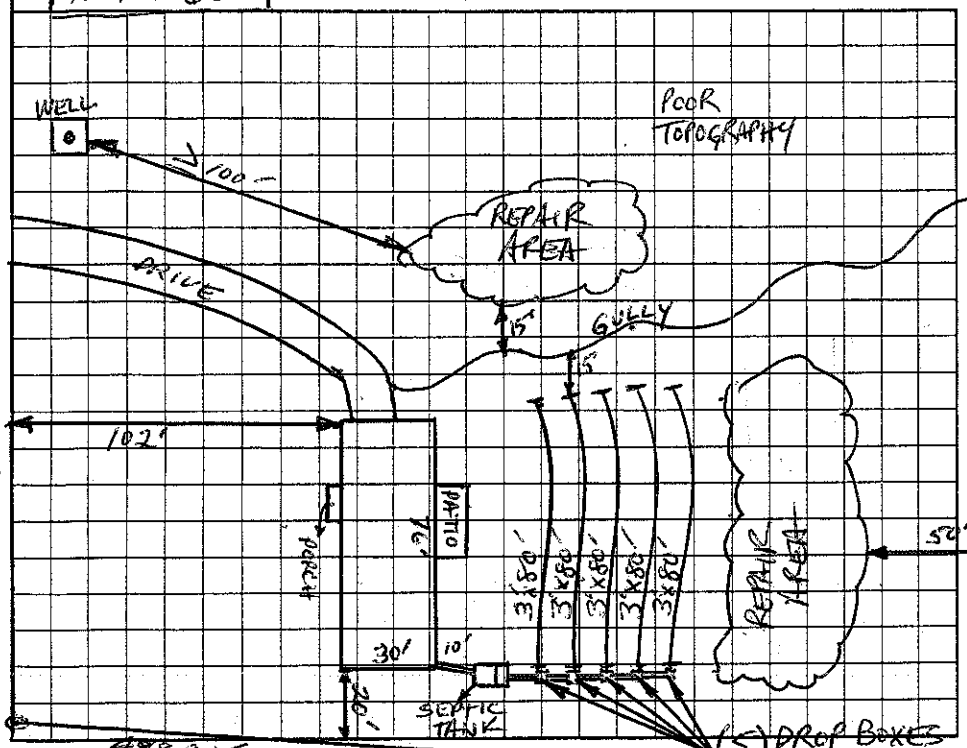

AS BUILT SKETCH

SYSTEM INSTALLED AS SHOWN IN INITIAL SITE SKETCH

Permit can be suspended or revoked if any false information is supplied toward securing the permit/any unauthorized changes are made to the site/any unauthorized changes are made in the installation of the system. Improvement Permit with plat valid without expiration. Improvement Permit with site plan valid for sixty months. Authorization to Construct is valid for a period equal to that of Improvement Permit – not to exceed sixty months.

Signed: Jerry W Eades Jr date 11/22/04 Installed by: KENNY MADISON

Improvement Permit by: Christopher M Shell RS date 11/15/04 Operation Permit by: Christopher M Shell RS, LSS date 6-22-05

Authorization to Construct by: Christopher M Shell RS date 11/15/04 Existing System Inspection by: date

HEALTH DEPT. COPY: WHITE OWNER COPY (FINAL): YELLOW OWNER COPY (INITIAL): PINK