IREDELL COUNTY HEALTH DEPARTMENT

STATESVILLE 704-878-5305 MOORESVILLE 704-664-5281

IMPROVEMENT PERMIT / AUTHORIZATION TO CONSTRUCT / OPERATION PERMIT / EXISTING SYSTEM INSPECTION

PERMIT# 124581 PIN# 4840-56-0742 DATE 11/15/04

OWNER OR CONTRACTOR WALLY EADES PHONE: Business (704) 838-3360 Home

ADDRESS 2143 JENNINGS RD. OLIN NC 28660

LOCATION I-77 N TL TOMLIN MILL RD TR JENNINGS 2.8 MILES TL CLAYBROOK AT END ON LEFT

SUBDIVISION BLOCK / SECTION LOT LOT AREA 6.5 SITE CLASS. PS DESIGN FLOW 480 L.T.A.R. 0.30 gpd/ft

Septic Tank: 1000 Gallons; STB 1007 Date 4-28-05

Pump Tank: Gallons; PT Date

Pump Make: Model Serial No.

Nitrification Field: No Fields 1 Square Feet 1600 Linear Feet 400

No Lines 5 Trench Width 36" Max Trench Bottom Depth 36" Gravel Depth N/A

☑ New System ☐ Repair System Type: I, II, III, IV, V, VI

System Description: GRAVITY 25% REDUCTION

Repair System Description: PUMP 25% REDUCTION

Maintenance Agreement Required: ☐ Yes ☑ No

☑ House/Mod. Home No. Bedrooms 4

☐ Mobile Home No. Bathrooms

☐ Business No. Employees

☐ Other

☐ Slab ☑ Crawl Space ☐ Basement w/plumbing ☐ Basement wo/plumbing

Water Supply: ☐ Individual ☐ Public ☑ Community


Comments:/Conditions: ① INSTALL ON CONTOUR ② MAINTAIN ALL SETBACKS

Comments:/Conditions: ZABEL FILTER W/ MARKER ON TANK

QUICK 4 CHAMBERS (STD-W 1H10)

* 1" = 60'

INITIAL SITE SKETCH

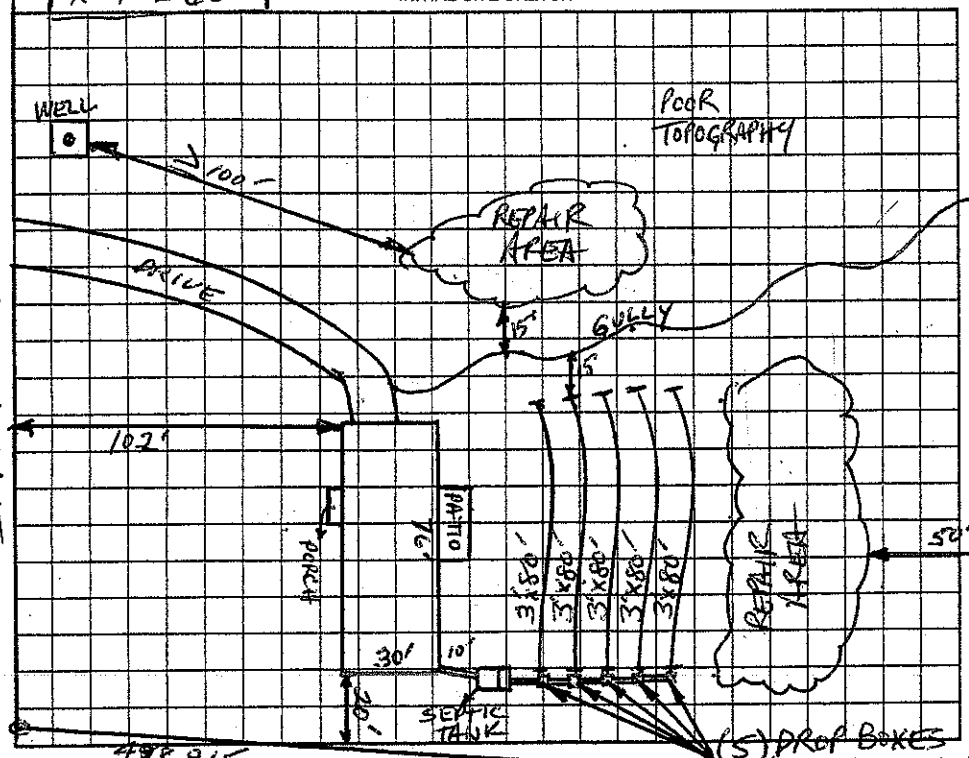

AS BUILT SKETCH

SYSTEM INSTALLED AS SHOWN IN INITIAL SITE SKETCH

The location of the proposed pole barn addition does not appear to impact the existing septic system.

**NOTE:

REHS

Date: 3-16-11

ICHD-Environmental Health Division

Permit can be suspended or revoked if any false information is supplied toward securing the permit/any unauthorized changes are made to the site/any unauthorized changes are made in the installation of the system. Improvement Permit with plat valid without expiration. Improvement Permit with site plan valid for sixty months. Authorization to Construct is valid for a period equal to that of Improvement Permit – not to exceed sixty months.

Signed: Jerry W Eades Jr date 11/22/04

Improvement Permit by: Christopher M Shell LS date 11/15/04

Authorization to Construct by: Christopher M Shell PS date 11/15/04

Installed by: KENNY MADISON

Operation Permit by: Christopher M Shell PS, LSS date 6-22-05

Existing System Inspection by: date

HEALTH DEPT. COPY: WHITE OWNER COPY (FINAL): YELLOW OWNER COPY (INITIAL): PINK