IREDELL COUNTY HEALTH DEPARTMENT

STATESVILLE 704-878-5305 MOORESVILLE 704-664-5281

IMPROVEMENT PERMIT / AUTHORIZATION TO CONSTRUCT / OPERATION PERMIT / EXISTING SYSTEM INSPECTION

PERMIT# 123942 PIN# 4840-90-0673 DATE 10/7/04

OWNER OR CONTRACTOR RIVERGREEN, LLC PHONE: Business (704) 609-7745 Home

ADDRESS PO BOX 1732 LINCOLNTON NC 28093

LOCATION I-77N TR TOMLIN MILL TL JOSEY TL OLIN LOT ON LEFT

SUBDIVISION OLIN GLEN BLOCK / SECTION 1 LOT 25 LOT AREA .4591 SITE CLASS. PS DESIGN FLOW 360 L.T.A.R. 0.3 gpd/ft²

Septic Tank: 1000 Gallons; STB 1012 Date 5-16-04
Pump Tank: Gallons; PT Date
Pump Make: Model Serial No.
Nitrification Field: No Fields 1 Square Feet 1200 Linear Feet 300
No Lines 4 Trench Width 36" Max Trench Bottom Depth 36" Gravel Depth N/A

☑ New System ☐ Repair System Type: I, II, (III) IV, V, VI
System Description: GRAVITY 25% REDUCTION
Repair System Description: LP PANEL 50% RED.
Maintenance Agreement Required: ☐ Yes ☑ No


☑ House/Mod. Home No. Bedrooms 3
☐ Mobile Home No. Bathrooms
☐ Business No. Employees
☐ Other
☐ Slab ☑ Crawl Space ☐ Basement w/plumbing ☐ Basement wo/plumbing

Water Supply: ☐ Individual ☑ Public ☐ Community


Comments/Conditions: ① INSTALL ON CONTOUR ② FRENCH DRAIN TO BE INSTALLED AT 48"

Comments/Conditions: ① ZABEL ② INFILTRATOR CHAMBERS ③ RISER 6" ABOVE GRADE ④ FRENCH DRAIN #5 STONE

1" = 40' INITIAL SITE SKETCH

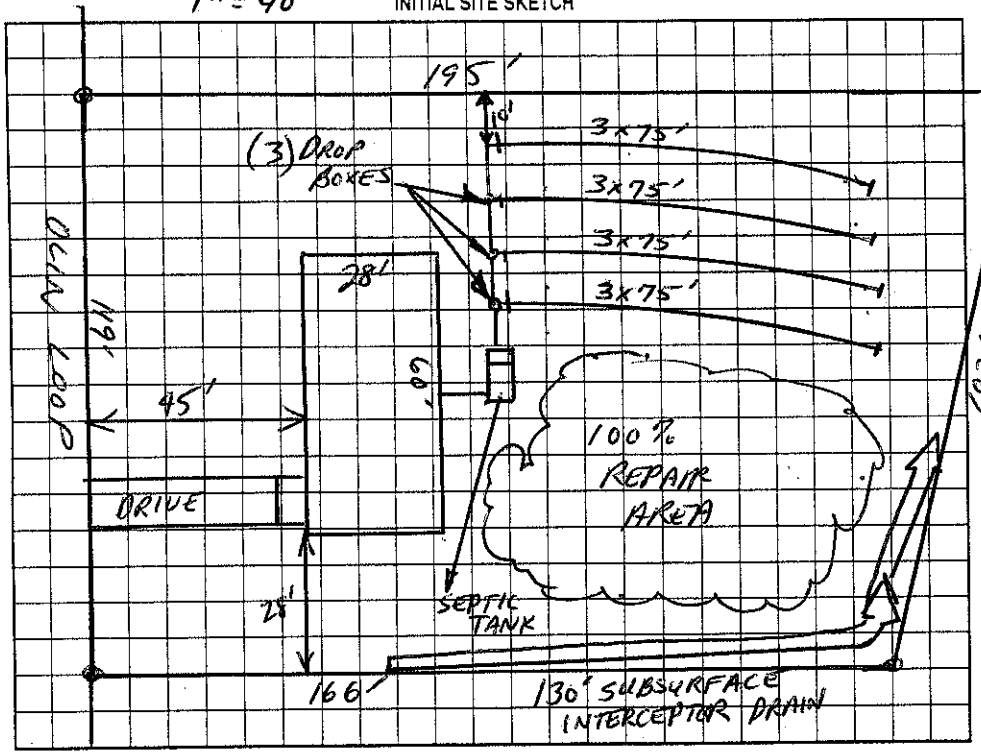

AS BUILT SKETCH

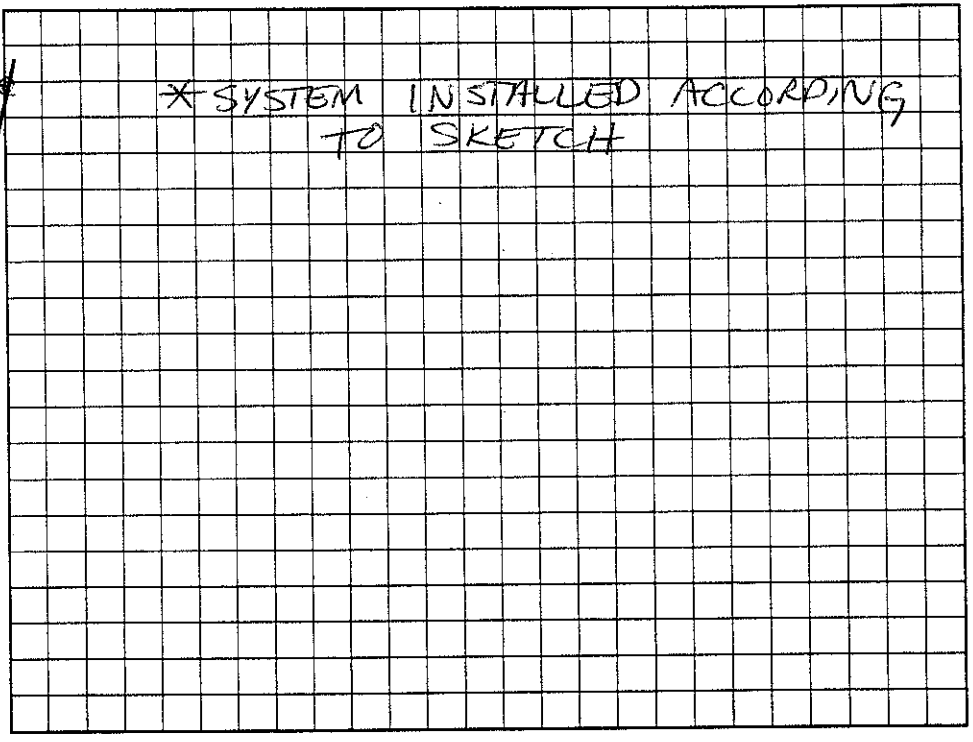

Permit can be suspended or revoked if any false information is supplied toward securing the permit/any unauthorized changes are made to the site/any unauthorized changes are made in the installation of the system. Improvement Permit with plat valid without expiration. Improvement Permit with site plan valid for sixty months. Authorization to Construct is valid for a period equal to that of Improvement Permit – not to exceed sixty months.

Signed: Arnold Arnold date 2 Nov 04 Installed by: A-1 BACKHOE

Improvement Permit by: Christopher M. Shirley, RS date 10/7/04 Operation Permit by: Christopher M. Shirley, RS date 11-17-04

Authorization to Construct by: Christopher M. Shirley, RS date 10/29/04 Existing System Inspection by: date

HEALTH DEPT. COPY: WHITE OWNER COPY (FINAL): YELLOW OWNER COPY (INITIAL): PINK