IREDELL COUNTY HEALTH DEPARTMENT

STATESVILLE 704-878-5305 (C1) MOORESVILLE 704-664-5281

IMPROVEMENT PERMIT / AUTHORIZATION TO CONSTRUCT / OPERATION PERMIT / EXISTING SYSTEM INSPECTION

PERMIT# 120 311 PIN# 4860 90 2696 DATE 6/16/04

OWNER OR CONTRACTOR RIVER GREEN LLC PHONE: Business 609-7745 Home

ADDRESS PO BOX 1732 LINCOLNTON - NC 28093

LOCATION ~~PO BOX 1732~~ 77N-TR TOMTEN MILL - TL JOSEY-TL OLEN GLEN ON LT

SUBDIVISION OLENGLEN BLOCK / SECTION 1 LOT 23 LOT AREA .51AC SITE CLASS. AS DESIGN FLOW 360GPD L.T.A.R. .360/Ft²

Septic Tank: 1000 Gallons; STB 1012 Date 4-21-04

Pump Tank: Gallons; PT Date

Pump Make: Model Serial No.

Nitrification Field: No Fields 1 Square Feet 900 Linear Feet 300

No Lines 4@75' Trench Width 36" Max Trench Bottom Depth 36" Gravel Depth N/A

☑ New System ☐ Repair System Type: I, II, III, IV, V, VI

System Description: GRAVITY 25% REDUCTION

Repair System Description: LP PANEL

Maintenance Agreement Required: ☐ Yes ☑ No

☑ House/Mod. Home No. Bedrooms 3

☐ Mobile Home No. Bathrooms 3

☐ Business No. Employees

☐ Other


☐ Slab ☑ Crawl Space ☐ Basement w/plumbing ☐ Basement wo/plumbing

Water Supply: ☐ Individual ☑ Public ☐ Community


Comments:/Conditions:

Comments:/Conditions: SEPTIC TANK WITH MARKER INSTALLED USING "TUFTITE" FILTER

INITIAL SITE SKETCH 1"=50'

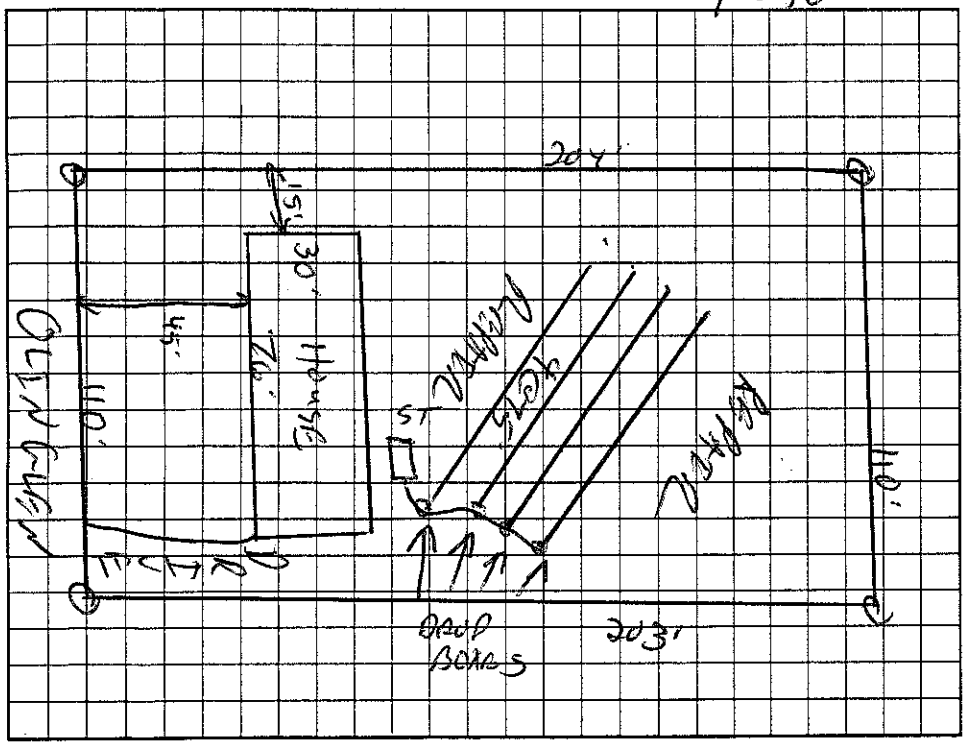

AS BUILT SKETCH

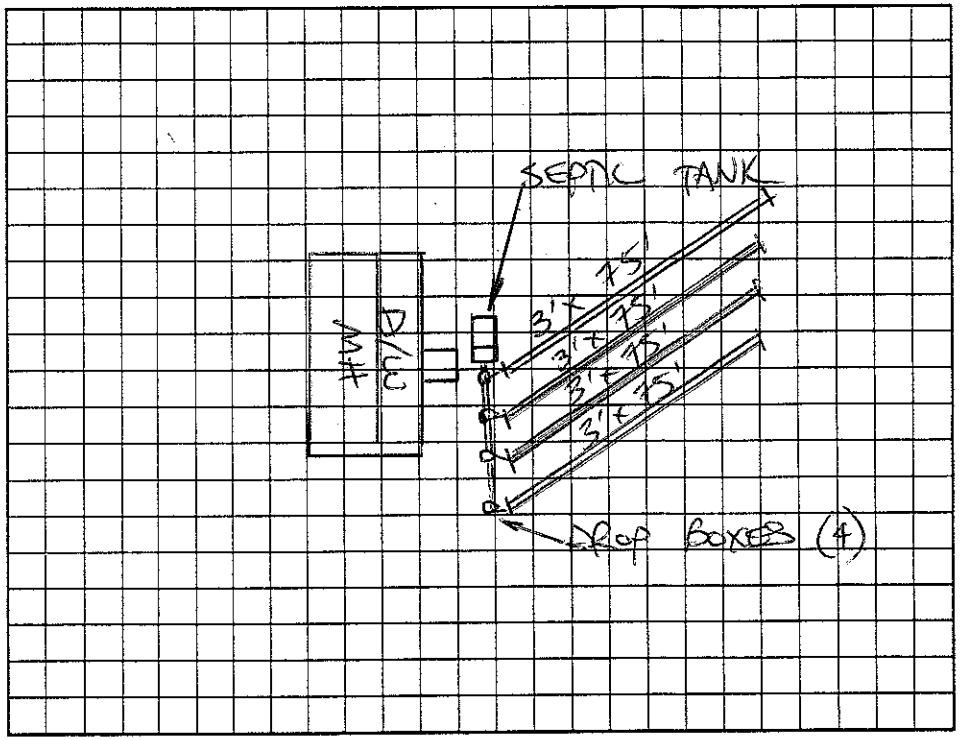

Permit can be suspended or revoked if any false information is supplied toward securing the permit/any unauthorized changes are made to the site/any unauthorized changes are made in the installation of the system. Improvement Permit with plat valid without expiration. Improvement Permit with site plan valid for sixty months. Authorization to Construct is valid for a period equal to that of Improvement Permit – not to exceed sixty months.

Signed: date 8/16/04 Installed by: CRAIG THOMPSON

Improvement Permit by: date 6/16/04 Operation Permit by: STEVE HEDRICK date 8-27-04

Authorization to Construct by: date 8/10/04 Existing System Inspection by: date

HEALTH DEPT. COPY: WHITE OWNER COPY (FINAL): YELLOW OWNER COPY (INITIAL): PINK