IREDELL COUNTY HEALTH DEPARTMENT

STATESVILLE 704-878-5305 (C1) MOORESVILLE 704-664-5281

IMPROVEMENT PERMIT / AUTHORIZATION TO CONSTRUCT / OPERATION PERMIT / EXISTING SYSTEM INSPECTION

PERMIT# 115560 PIN# 4840-90-4993

OWNER OR CONTRACTOR FLEETWOOD OF TROUTMAN DATE 9-29-03

ADDRESS 1040 CHARLOTTE HWY TROUTMAN, NC 28166 PHONE: Business 704-528-7108 Home

LOCATION JENNINGS RD NORTH, (R) OLEN LOOP 1/4 mile on Left LOT #1

SUBDIVISION OLEN GLEN BLOCK / SECTION 1 LOT 1 LOT AREA .4712 AC SITE CLASS. PS DESIGN FLOW 360 L.T.A.R. .3

Septic Tank: 1000 Gallons; STB 1012 Date 5-9-03

Pump Tank: Gallons; PT Date

Pump Make: Model Serial No.

Nitrification Field: No Fields 1 Square Feet ER=1200' Linear Feet 300'

No Lines 3x100' Trench Width 36" Max Trench Bottom Depth 36" Gravel Depth N/A

☒ New System ☐ Repair System Type: I, II, (III), IV, V, VI

System Description: GRAV 25% RED

Repair System Description: LP PANEL

Maintenance Agreement Required: ☐ Yes ☒ No

☐ House/Mod. Home ☒ Mobile Home D/W ☐ Business ☐ Other

No. Bedrooms 3 No. Bathrooms 2 No. Employees


☐ Slab ☒ Crawl Space ☐ Basement w/plumbing ☐ Basement wo/plumbing

Water Supply: ☐ Individual ☒ Public ☐ Community

Comments:/Conditions: (1) HOUSE AND SYSTEM IS FLAGGED OUT (2) INSTALL LINES ON CONTOURS (3) MAINTAIN SETBACKS

Comments:/Conditions: SEPTIC TANK WITH MARKER INSTALLED USING "TUFTITE" FILTER

INITIAL SITE SKETCH

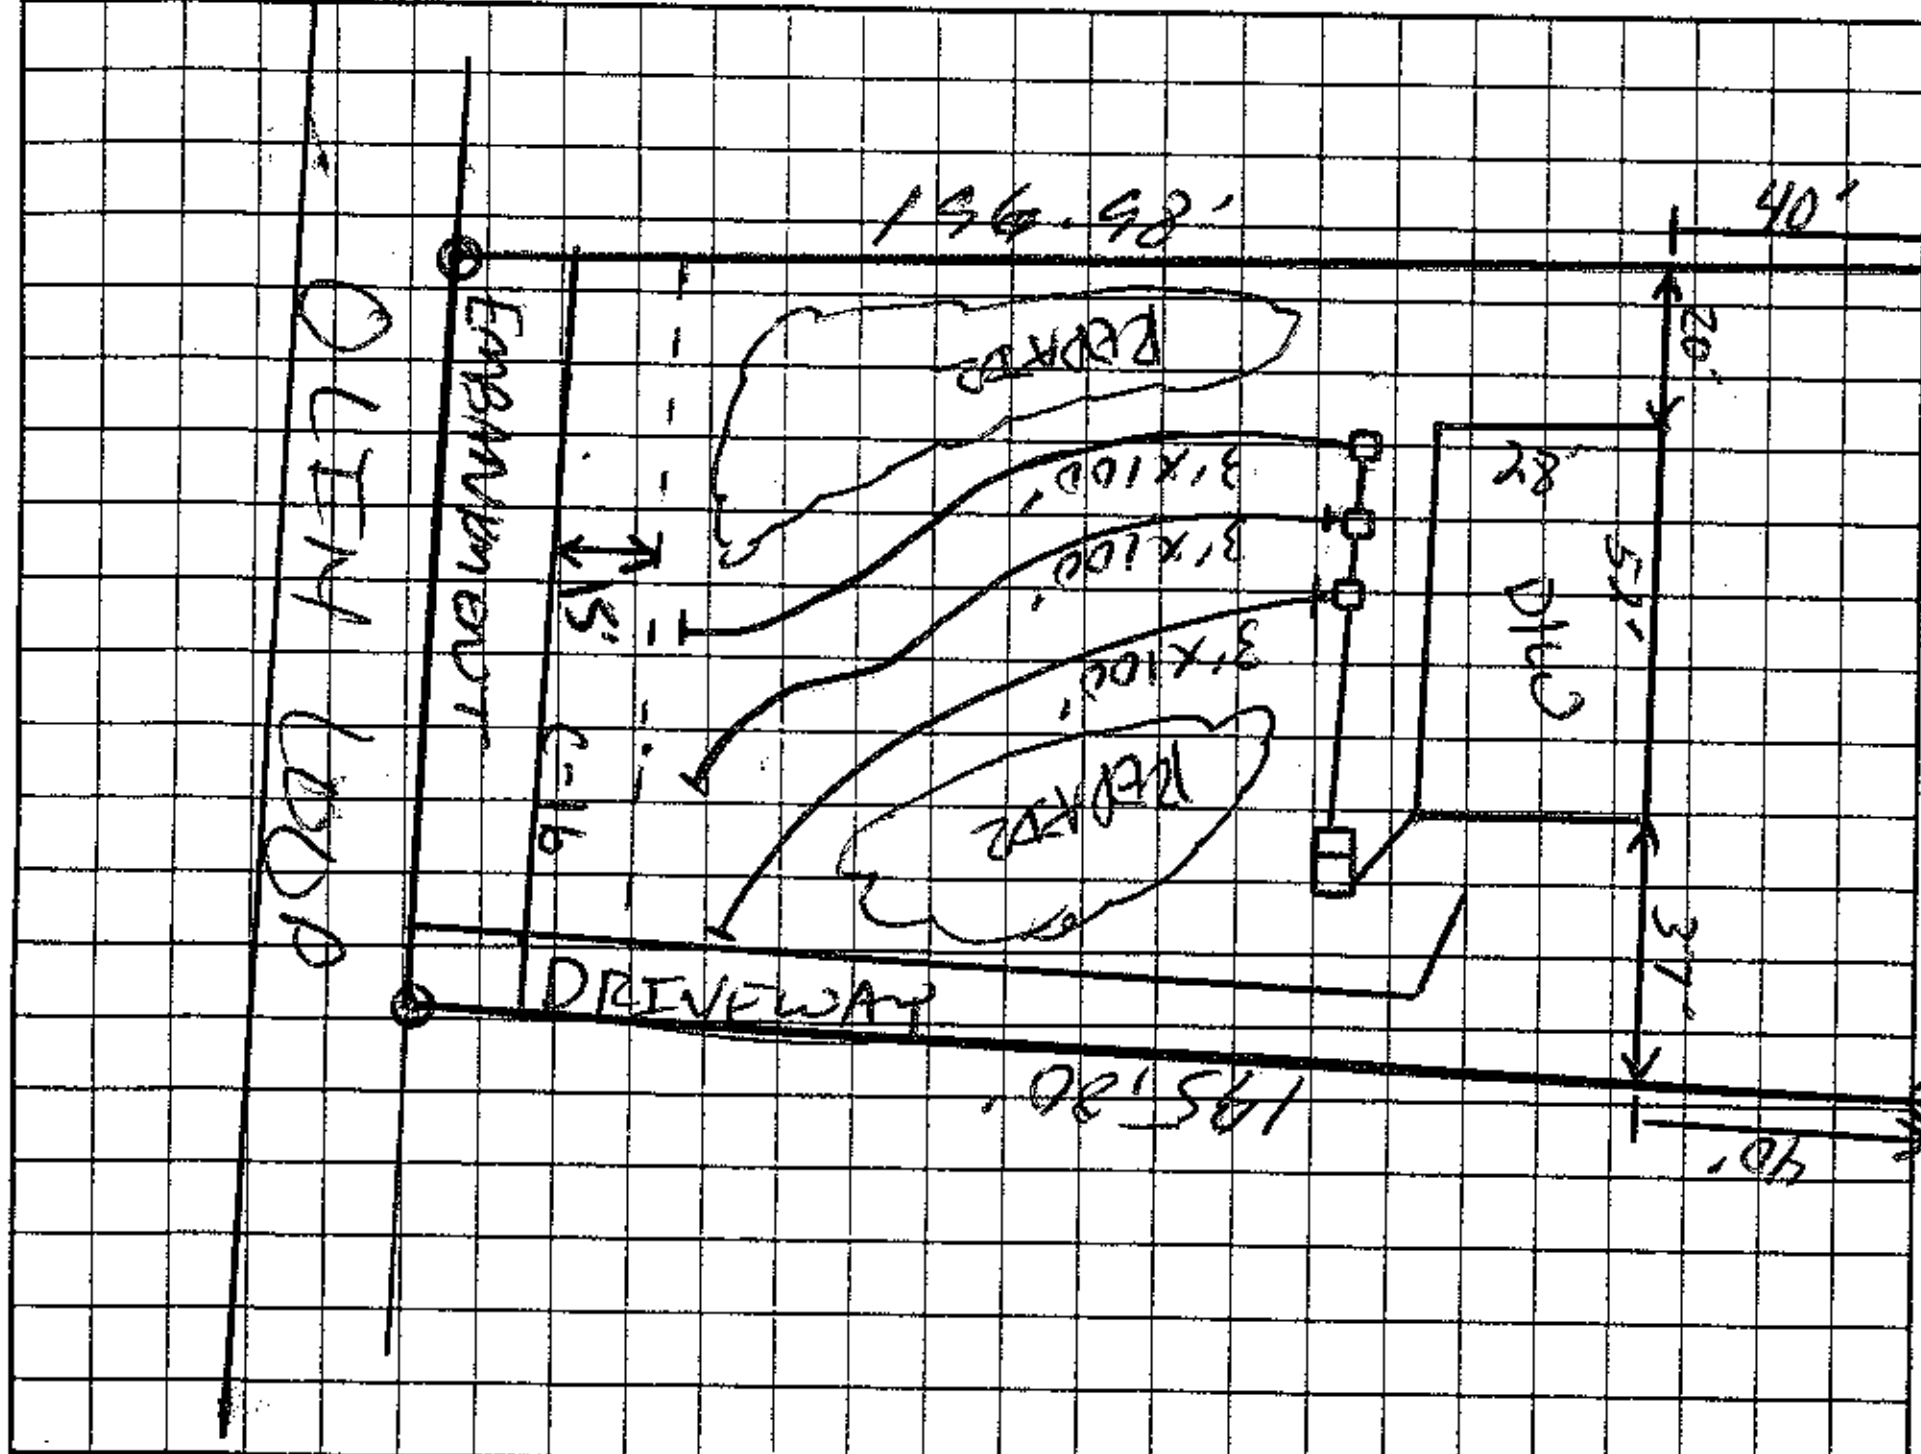

AS BUILT SKETCH

SYSTEM INSTALLED ACCORDING TO INITIAL SITE SKETCH

Permit can be suspended or revoked if any false information is supplied toward securing the permit/any unauthorized changes are made to the site/any unauthorized changes are made in the installation of the system. Improvement Permit with plat valid without expiration. Improvement Permit with site plan valid for sixty months. Authorization to Construct is valid for a period equal to that of Improvement Permit – not to exceed sixty months.

Signed: [signature] date 10-3-03

Improvement Permit by: [signature] date 9-29-03

Authorization to Construct by: [signature] date 9-29-03

Installed by: CRAIG THOMPSON

Operation Permit by: STEVE HEDRICK date 11-3-03

Existing System Inspection by: date

HEALTH DEPT. COPY: WHITE OWNER COPY (FINAL): YELLOW OWNER COPY (INITIAL): PINK