IREDELL COUNTY HEALTH DEPARTMENT

Statesville Office (704) 878-5305 Mooresville Office (704) 660-3625 PERMIT # 22017

IMPROVEMENT PERMIT / AUTHORIZATION TO CONSTRUCT / OPERATION PERMIT / EXISTING SYSTEM

PIN # ~~4664064~~ 4840906294

APPLICANT: ROLLANS SOIL APPLICANT ADDRESS: PO BOX 832 MOORESVILLE 5275

SITE ADDRESS: 171 CORA LN OLIN PHONE: ALT. PHONE: 704 746 5046

SITE DIRECTIONS: 77 N TO MULLIN MILL RD - TL JOSEY - TL OLIN LOOP - TL CORA LN

SUBDIVISION: OLIN RIDGE SECTION: 2 LOT # 11/12 LOT AREA: 1 AC DESIGN FLOW: 360 L.T.A.R.: .2

Septic Tank 1000 (gal)	STB 760	Date 6-28-16	☑ New System ☐ Repair ☐ Expansion	System Type: I II (III) IV V VI	☑ Residence	No. Bedrooms 3	Water Supply
Pump Tank (gal)	PT	Date	System Description: GRAVITY SHALLOW 25% REDUCTION		☐ Business	No. Persons 6	☑ Private
Pump Make	Model	Serial #	Repair System Description: SAME		☐ Other	No. Employees	☐ Public
# Nitrification Fields 1	# Lines 5	Linear Ft: 460	Maintenance Agreement Required: ☐ YES ☑ NO		☐ Slab	☑ Crawl Space	☐ Community
Trench Width 36"	Max. Trench Bottom Depth (18")	Gravel Depth N/A	☑ GRAVITY ☐ PRESSURE		☐ Basement w/plumbing	☐ Basement w/o plumbing	

Comments / Conditions: DO NOT ISSUE A/C UNTIL LOTS ARE DEEDED & RECORDED PROPERLY

★FRENCH DRAIN REQUIRED★

9/22/16 Checked Septic System & French drains

INITIAL SITE SKETCH

See Rollans Soil & Environmental's Design

AS BUILT SKETCH

Permit can be suspended or revoked if any false information is supplied toward securing the permit / any unauthorized changes are made to the site / any unauthorized changes are made in the installation of the system. **CONTACT A LOCATOR SERVICE PRIOR TO ANY EXCAVATION**

☐ **IMPROVEMENT PERMIT** *with plat valid without expiration.* ☑ **IMPROVEMENT PERMIT** *with site plan valid for 60 mos.* ☑ **AUTHORIZATION TO CONSTRUCT** *valid for period equal to IMPROVEMENT PERMIT--not to exceed 60 mo.*

Owner / Applicant Signature: Samuel A Rollans Date:

IMPROVEMENT PERMIT by: Date: 7/16/16

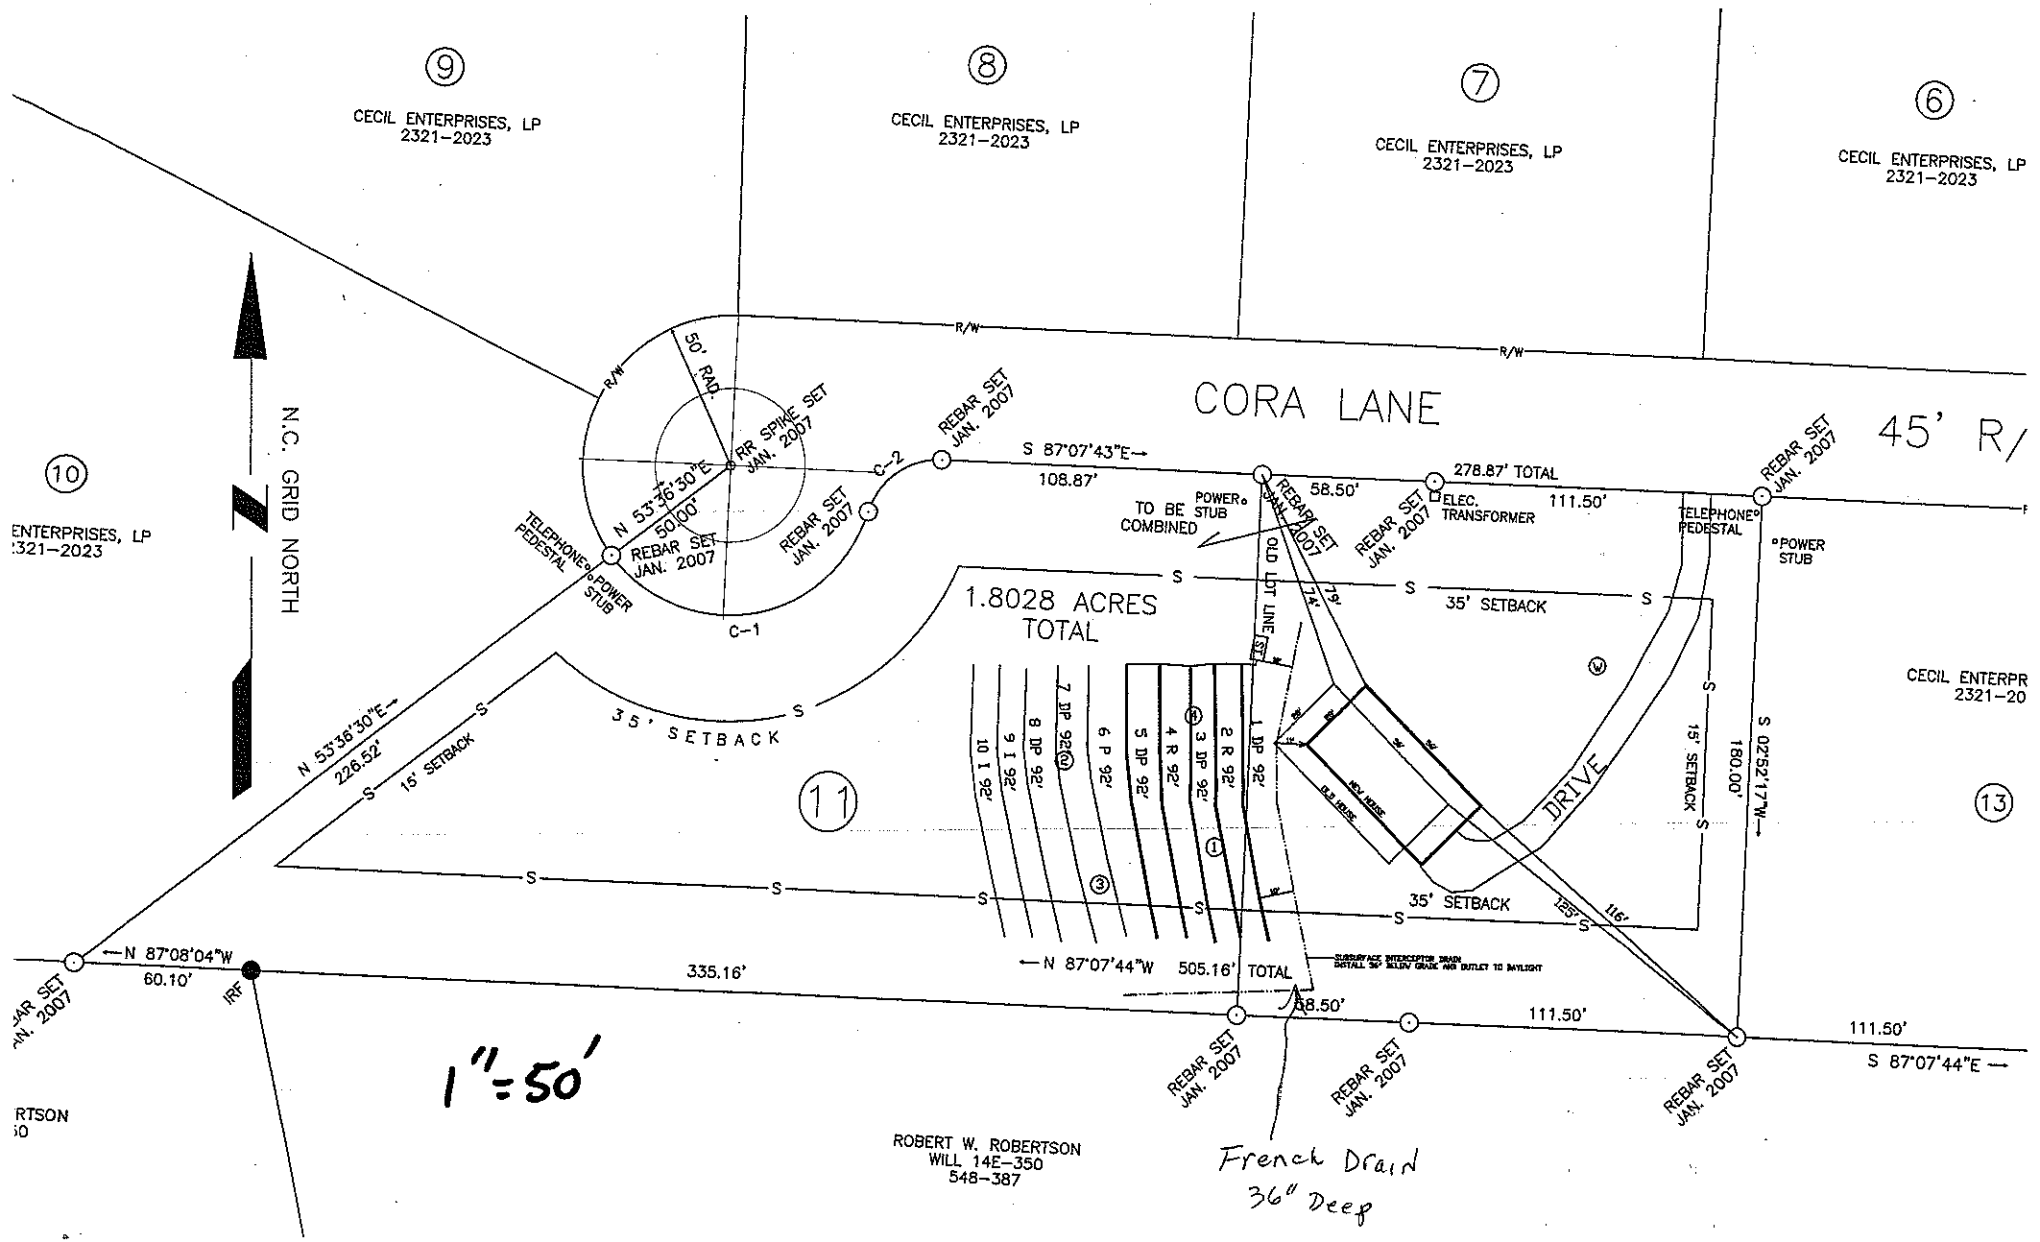
AUTHORIZATION TO CONSTRUCT by: Date: 8/30/16

Installed by: Aqua Drill

OPERATION PERMIT by: Marina Dotson Date: 9/22/16

Existing System Inspected by: Date:

Health Dept. Copy - WHITE Applicant (Final Approval) - YELLOW Applicant (Conditional Approval) - PINK


⑨
CECIL ENTERPRISES, LP
2321–2023
⑧
CECIL ENTERPRISES, LP
2321–2023
⑦
CECIL ENTERPRISES, LP
2321–2023
⑥
CECIL ENTERPRISES, LP
2321–2023
⑩
ENTERPRISES, LP
:321–2023
N.C. GRID NORTH
R/W
CORA LANE
45' R/
50' RAD.
RR SPIKE SET JAN. 2007
REBAR SET JAN. 2007
C-2
C-1
S 87°07'43"E
108.87'
N 53°36'30"E
50.00'
TELEPHONE PEDESTAL
POWER STUB
TO BE COMBINED
58.50'
278.87' TOTAL
111.50'
ELEC. TRANSFORMER
TELEPHONE PEDESTAL
POWER STUB
1.8028 ACRES
TOTAL
OLD LOT LINE
35' SETBACK
15' SETBACK
N 53°36'30"E
226.52'
11
1 DP 92'
2 R 92'
3 DP 92'
4 R 92'
5 DP 92'
6 P 92'
7 DP 92'
8 DP 92'
9 I 92'
10 I 92'
DRIVE
NEW HOUSE
OLD HOUSE
180.00'
S 02°52'17"W
CECIL ENTERPR
2321–20
13
N 87°08'04"W
60.10'
335.16'
IRF
N 87°07'44"W 505.16' TOTAL
SUBSURFACE INTERCEPTOR DRAIN
111.50'
S 87°07'44"E
1"=50'
ROBERT W. ROBERTSON
WILL 14E–350
548–387
French Drain
36" Deep