IREDELL COUNTY HEALTH DEPARTMENT

STATESVILLE 704-878-5305 MOORESVILLE 704-664-5281

IMPROVEMENT PERMIT / AUTHORIZATION TO CONSTRUCT / OPERATION PERMIT / EXISTING SYSTEM INSPECTION

PERMIT# 118051 PIN# 4840-90-7638 DATE 1-27-04

OWNER OR CONTRACTOR SCHULT HOUSING PHONE: Business (704) 902-1836 Home

ADDRESS 134 KOA LANE STATESVILLE 28677

LOCATION 21N (L) JENNINGS (A) OLIN LOT #19 ON (R)

SUBDIVISION OLIN GLEN BLOCK / SECTION 1 LOT 19 LOT AREA .50 SITE CLASS. PS DESIGN FLOW 360 L.T.A.R. .3 gpd/ft²

Septic Tank: 1000 Gallons; STB 1012 Date 8-16-03

Pump Tank: Gallons; PT Date

Pump Make: Model Serial No.

Nitrification Field: No Fields 1 Square Feet EQ 1200 Linear Feet 300

No Lines 3 Trench Width 36" Max Trench Bottom Depth 18"

☑ New System ☐ Repair System Type: I, II, (III) IV, V, VI

System Description: GRAVITY 25% REDUCT.

Repair System Description: PUMP 25% REDUCT.

Maintenance Agreement Required: ☐ Yes ☑ No

Gravel Depth N/A ☐ Slab ☑ Crawl Space ☐ Basement w/plumbing ☐ Basement wo/plumbing

☑ House/Mod. Home No. Bedrooms 3

☐ Mobile Home No. Bathrooms 2

☐ Business No. Employees


☐ Other

Water Supply: ☐ Individual ☑ Public ☐ Community

Comments:/Conditions: ① INSTALL LINES 18" ON CONTOUR ② MAINTAIN ALL SETBACKS ③ INSTALL ACCORDING TO SKETCH ④ CALL W/ QUESTIONS

Comments:/Conditions: ① TUFF TITE FILTER ② INSTALLED AS IN SKETCH

INITIAL SITE SKETCH SCALE 1" = 40'

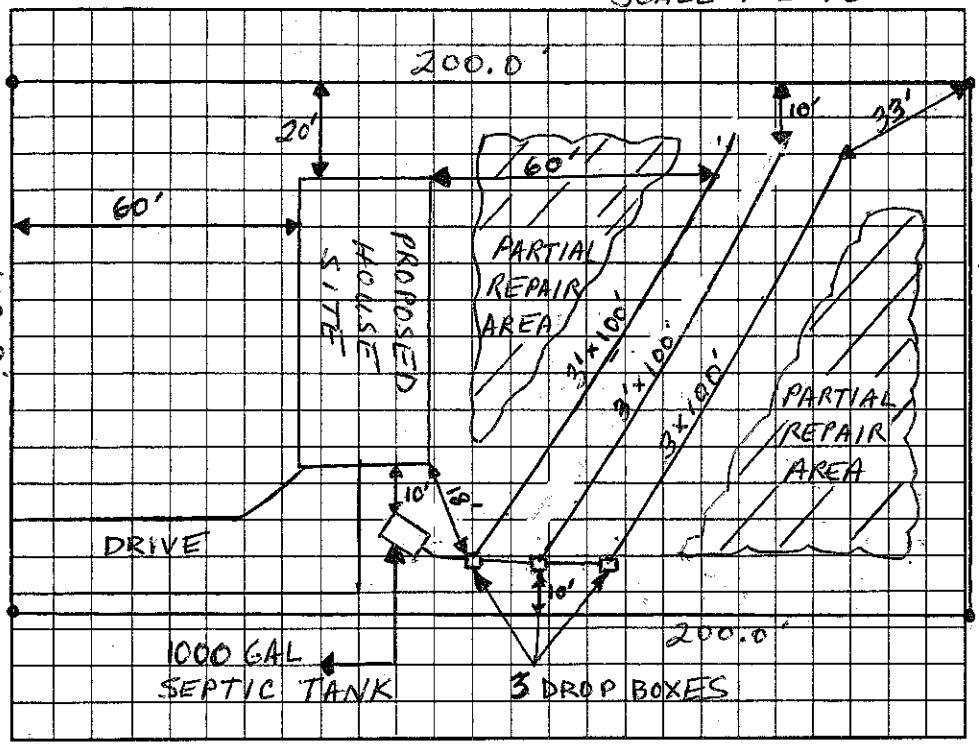

AS BUILT SKETCH

Permit can be suspended or revoked if any false information is supplied toward securing the permit/any unauthorized changes are made to the site/any unauthorized changes are made in the installation of the system. Improvement Permit with plat valid without expiration. Improvement Permit with site plan valid for sixty months. Authorization to Construct is valid for a period equal to that of Improvement Permit – not to exceed sixty months.

Signed: Sarah Kundy date 1-30-04 Installed by: A-1 Backhoe

Improvement Permit by: Christopher M. Sherrill, R.S. date 1-27-04 Operation Permit by: Christopher M. Sherrill, R.S. date 2-5-04

Authorization to Construct by: Christopher M. Sherrill, R.S. date 1-27-04 Existing System Inspection by: date

HEALTH DEPT. COPY: WHITE OWNER COPY (FINAL): YELLOW OWNER COPY (INITIAL): PINK