IREDELL COUNTY HEALTH DEPARTMENT

STATESVILLE 704-878-5305 MOORESVILLE 704-664-5281

IMPROVEMENT PERMIT / AUTHORIZATION TO CONSTRUCT / OPERATION PERMIT / EXISTING SYSTEM INSPECTION

PERMIT# 125256 PIN# 4840-90-8953 DATE 2-9-05

OWNER OR CONTRACTOR RIVER GREEN, LLC PHONE: Business (704) 609-7745 Home

ADDRESS PO BOX 1732 LINCOLNTON, NC 28093

LOCATION I-77N TL TOMLIN MILL RD TR JENNINGS TR OLIN LP ON LEFT

SUBDIVISION OLIN GLEN BLOCK / SECTION I LOT 6 LOT AREA 0.4607 SITE CLASS. PS DESIGN FLOW 360 L.T.A.R. 0.30 gpd/ft²

Septic Tank: 1000 Gallons; STB 760 Date 10-19-04

Pump Tank: Gallons; PT Date

Pump Make: Model Serial No.

Nitrification Field: No Fields 1 Square Feet 1200 Linear Feet 300'

No Lines 3 Trench Width 36" Max Trench Bottom Depth 20" Gravel Depth N/A

☑ New System ☐ Repair System Type: I, II, III, IV, V, VI

System Description: GRAVITY 25% REDUCTION

Repair System Description: LOW-PRESSURE PIPE

Maintenance Agreement Required: ☐ Yes ☑ No

☐ House/Mod. Home No. Bedrooms 3

☑ Mobile Home No. Bathrooms

☐ Business No. Employees

☐ Other


☐ Slab ☑ Crawl Space ☐ Basement w/plumbing ☐ Basement wo/plumbing

Water Supply: ☐ Individual ☑ Public ☐ Community

Comments/Conditions: ① INSTALL LINES 20" ON CONTOUR ② MAINTAIN SETBACKS ③ INSTALL SURFACE SWALE ABOVE SYSTEM

Comments/Conditions: ① RED "POLYLOK" FILTER ② NO RISER ON TANK <6" FROM GRADE ③ QUICK 4 CHAMBERS USED (STD-W 1H0) ④ NO WARRANTY W/ THIS #

INITIAL SITE SKETCH

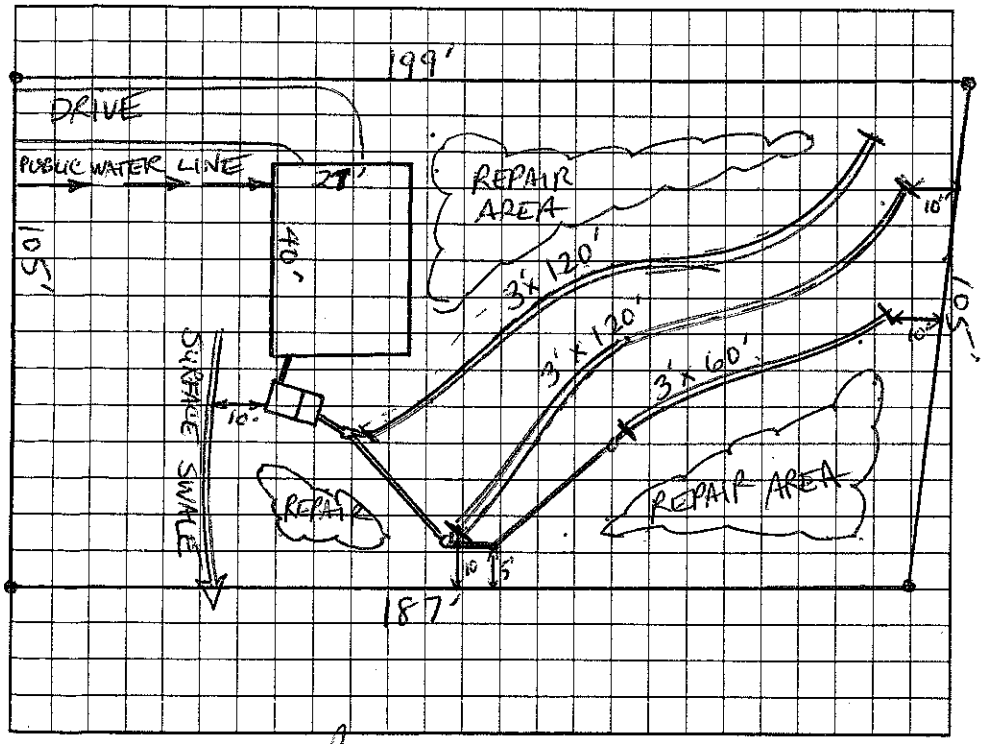

AS BUILT SKETCH

* SYSTEM INSTALLED AS SHOWN IN SKETCH

Permit can be suspended or revoked if any false information is supplied toward securing the permit/any unauthorized changes are made to the site/any unauthorized changes are made in the installation of the system. Improvement Permit with plat valid without expiration. Improvement Permit with site plan valid for sixty months. Authorization to Construct is valid for a period equal to that of Improvement Permit – not to exceed sixty months.

Signed: date 2/10/05 Installed by: ABEE'S GRADING

Improvement Permit by: Christy M. Shell LRS, LSS date 2-9-05 Operation Permit by: Christy M. Shell LRS, LSS date 2-16-05

Authorization to Construct by: Christy M. Shell LRS, LSS date 2-9-05 Existing System Inspection by: date

HEALTH DEPT. COPY: WHITE OWNER COPY (FINAL): YELLOW OWNER COPY (INITIAL): PINK