IREDELL COUNTY HEALTH DEPARTMENT

STATESVILLE 704-878-5305 (CI) MOORESVILLE 704-664-5281

IMPROVEMENT PERMIT / AUTHORIZATION TO CONSTRUCT / OPERATION PERMIT / EXISTING SYSTEM INSPECTION

PERMIT# 114888 PIN# 4840-91-7136 DATE 9-23-03

OWNER OR CONTRACTOR ERIC PEARCE PHONE: Business 704-872-6179 Home 704-400-7019

ADDRESS 1270 NORTH SIDE DR STATESVILLE, NC 28625

LOCATION 21 NORTH, (L) JENNINGS (R) OLD LOOP ≈ 1/2 mile on LEFT LOT #4 OFF ROAD

SUBDIVISION OLIN GLENN BLOCK / SECTION 1 LOT 4 LOT AREA 1.5367 AC SITE CLASS. PS DESIGN FLOW 360 L.T.A.R. .3

Septic Tank: 1000 Gallons; STB 1017 Date 3-1-03
Pump Tank: _____ Gallons; PT _____ Date _____
Pump Make: _____ Model _____ Serial No. _____
Nitrification Field: No Fields 1 Square Feet EQ=1200' Linear Feet 300'
No Lines 3 Trench Width 36 Max Trench Bottom Depth 36" MIN Gravel Depth N/A

☑ New System ☐ Repair System Type: I, II, (III), IV, V, VI
System Description: GRAV 25% REDUCT
Repair System Description: LP PANEL
Maintenance Agreement Required: ☐ Yes ☒ No


☒ House/Mod. Home No. Bedrooms 3
☐ Mobile Home No. Bathrooms 2
☐ Business No. Employees ____
☐ Other _____
☐ Slab ☒ Crawl Space ☐ Basement w/plumbing ☐ Basement wo/plumbing

Water Supply: ☐ Individual ☒ Public ☐ Community

Comments/Conditions: (1) INSTALL DRAINLINES 36" DEEP (2) INSTALL LINES ON CONTOURS (3) MAINTAIN SETBACKS (4) SYSTEM + HOUSE FLAGGED OFF COMPLETELY (5) MAINTAIN 25' UPSLOPE FROM WASHOUTS WITH REPAIR

Comments/Conditions: MAY REQUIRE SOME EFFLUENT (6) KEEP TRENCH TO DIVERT SURFACE H2O. NOTE RULE ATTACHED 15A NCAC 18A .1956 (5). "STEEP SLOPES." TUFFTITE FILTER MARKER

INITIAL SITE SKETCH

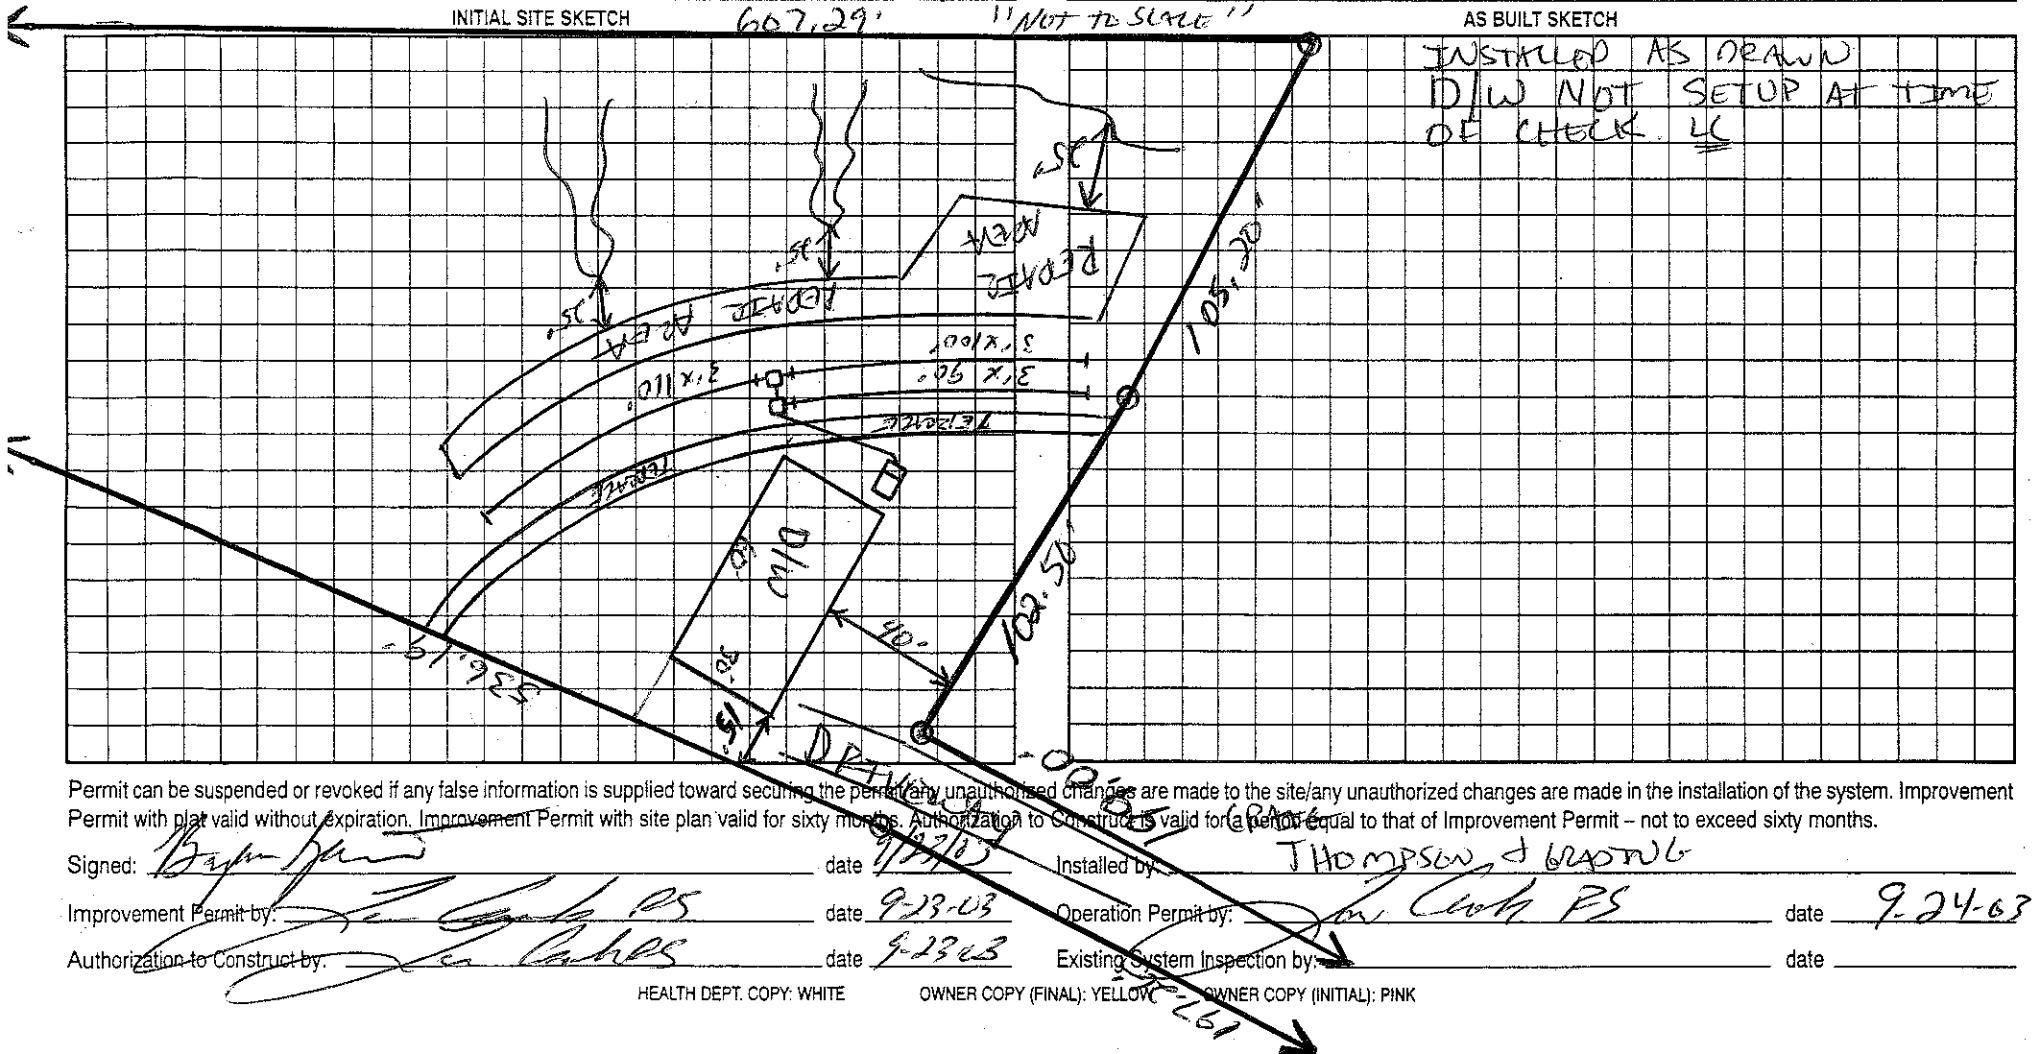

AS BUILT SKETCH

INSTALLED AS DRAWN D/W NOT SETUP AT TIME OF CHECK. LC

Permit can be suspended or revoked if any false information is supplied toward securing the permit/any unauthorised changes are made to the site/any unauthorized changes are made in the installation of the system. Improvement Permit with plat valid without expiration. Improvement Permit with site plan valid for sixty months. Authorization to Construct is valid for a period equal to that of Improvement Permit – not to exceed sixty months.

Signed: _____ date 9/23/03 Installed by: THOMPSON & GRADING

Improvement Permit by: _____ PS date 9-23-03 Operation Permit by: _____ PS date 9-24-03

Authorization to Construct by: _____ date 9-23-03 Existing System Inspection by: _____ date _____

HEALTH DEPT. COPY: WHITE OWNER COPY (FINAL): YELLOW OWNER COPY (INITIAL): PINK