IREDELL COUNTY HEALTH DEPARTMENT STATESVILLE 704-878-5305 MOORESVILLE 704-664-5281

IMPROVEMENT PERMIT / AUTHORIZATION TO CONSTRUCT / OPERATION PERMIT / EXISTING SYSTEM INSPECTION

PERMIT # 154233 PIN # 4846965834 DATE 18 Dec 08

OWNER or APPLICANT Freedom Homes - Joseph Templeton PHONE: Business Home: 704-528-7960

OWNER or APPLICANT ADDRESS 1042 Charlotte Highway Troutman

LOCATION / DIRECTIONS Jennings Road (1112) Red Hawk Site on left

SUBDIVISION Glen Acres BLOCK / SECTION 2 LOT # 20A LOT AREA 1.009 DESIGN FLOW 360 L.T.A.R. .2

Septic Tank 1000 Gallons: STB 760 Date 7-16-08
Pump Tank Gallons: P T Date
Pump Make Model Serial #
Nitrification Field No Fields No Lines 3 Linear Feet 300
Trench Width 36 Max. Trench Bottom Depth 36" Gravel Depth NA ☒ GRAVITY ☐ PRESSURE

☒ New System ☐ Repair ☐ Expansion System Type (I II) IV, V VI
System Description: 25% Gravity
Repair System Description: 25% Pump
Maintenance Agreement Required ☒ YES ☐ NO


☒ Residence No. Bedrooms 3
☐ Business No. Persons
☐ Other No. Employees
☐ Slab ☒ Crawl Space
☐ Basement w/plumbing ☐ Basement w/o plumbing

Water Supply
☒ Private
☐ Public
☐ Community

Comments / Conditions
Maintain 15' off 2½ cut
Maintain 100' away from well

Comments / Conditions
Maintain all setbacks
Install on contour
House is 82' from Road

INITIAL SITE SKETCH

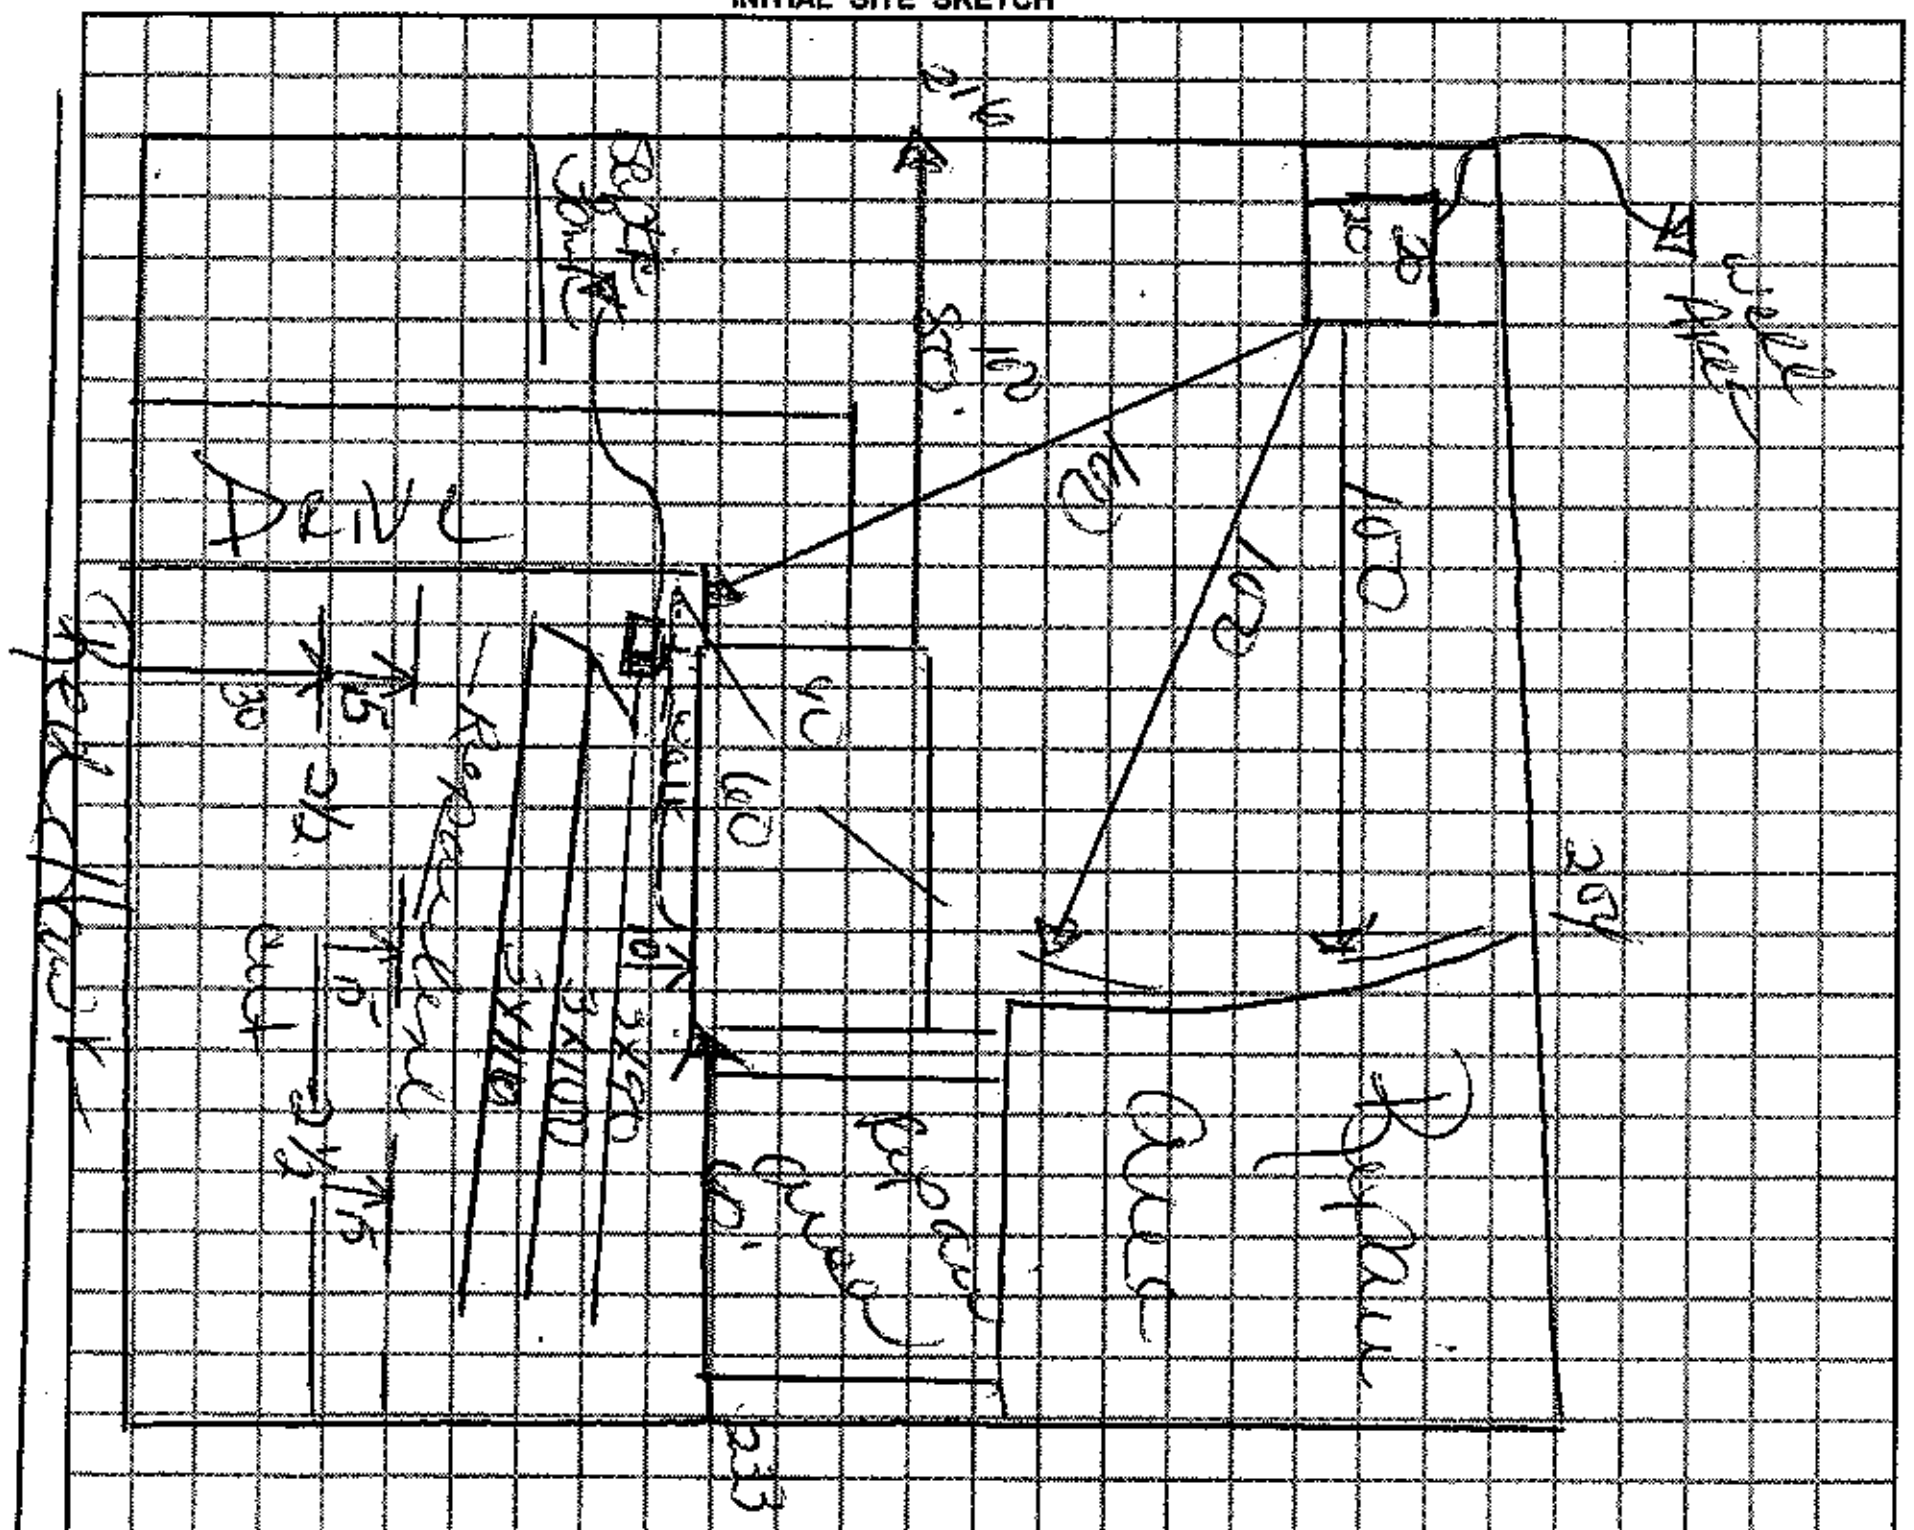

AS BUILT SKETCH

Red Leaf Hill
Septic Maker

Permit can be suspended or revoked if any false information is supplied toward securing the permit / any unauthorized changes are made to the site / any unauthorized changes are made in the installation of the system.

☐ *IMPROVEMENT PERMIT w / plat valid without expiration.* ☐ *IMPROVEMENT PERMIT w / site plan valid for 60 mos.* ☒ *AUTHORIZATION TO CONSTRUCT valid for period equal to IMPROVEMENT PERMIT-not to exceed 60 mo.*

Owner / Applicant Signature: [signature] Date 18 Dec 08
Improvement Permit by: [signature] Cook Date 18 Dec 08
Authorization to Construct by: [signature] Cook Date 18 Dec 08

Installed by: H-L Mark Noe
Operation Permit by: [signature] Cook Date: 1-16-09
Existing System Inspected by: Date:

YOU SHOULD CONTACT A LOCATOR SERVICE PRIOR TO ANY EXCAVATION.

WHITE COPY Environmental Health YELLOW COPY (Final) Owner / Applicant PINK COPY (Initial) Owner / Applicant