IREDELL COUNTY HEALTH DEPARTMENT

STATESVILLE 704-878-5305 MOORESVILLE 704-664-5281

IMPROVEMENT PERMIT / AUTHORIZATION TO CONSTRUCT / OPERATION PERMIT / EXISTING SYSTEM INSPECTION

PERMIT# 078461 PIN# 4840 96 7469 DATE 1-16-99

OWNER OR CONTRACTOR LUCIA SARCONA PHONE: Business Home (609) 490-0571

ADDRESS 400 DUTCHNECK ROAD, EAST WINDSON NJ 08520

LOCATION US 21 N, TL JENNINGS ROAD, TR RED HAWK LANE, 2ND LOT ON RIGHT

SUBDIVISION GLEN ACRES BLOCK / SECTION ____ LOT 2 LOT AREA 1.833 ACRES SITE CLASS PS DESIGN FLOW 360 L.T.A.R. 0.30 gpd/ft²

Septic Tank: 1000 Gallons; STB 1012 Date 12-11-99

Pump Tank: ____ Gallons; PT ____ Date ____

Pump Make: ____ Model ____ Serial No. ____

Nitrification Field: No. Fields 1 Square Feet 1200 Linear Feet 400

No. Lines FOUR Trench Width 36" Max Trench Bottom Depth 36" Gravel Depth ____

(X) New System [ ] Repair System Type: [ ] I [X] II [ ] III, IV, V, VI

System Description: CONVENTIONAL GRAVITY

Repair System Description: CONV. GRAVITY

Maintenance Agreement Required: [ ] Yes [X] No

[ ] House/Mod. Home No. Bedrooms 3

[X] Mobile Home No. Bathrooms 2

[ ] Business No. Employees ____

[ ] Other ____


[ ] Slab [X] Crawl Space [ ] Basement w/plumbing [ ] Basement wo/plumbing

Water Supply: [X] Individual [ ] Public [ ] Community WELL

Comments/Conditions: KEEP SYSTEM MINIMUM 100' FROM WELL SITE

Comments/Conditions: "POLYLOK" FILTER INSTALLED AT OUTLET OF SEPTIC TANK

INITIAL SITE SKETCH SCALE: 1"=60'

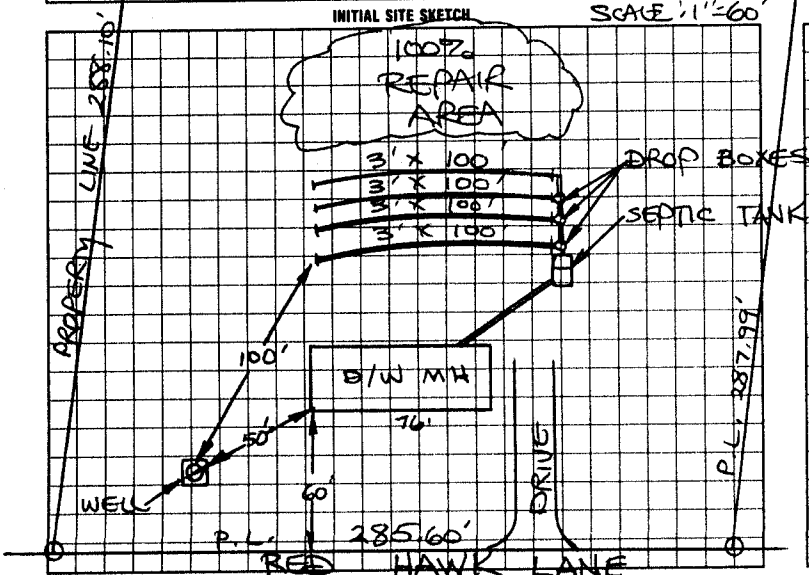

AS BUILT SKETCH

SYSTEM INSTALLED ACCORDING TO INITAL SITE SKETCH

I understand that this permit can be suspended or revoked if any false information is supplied toward securing the permit/any unauthorized changes are made to the site/any unauthorized changes are made in the installation of the system. Improvement Permit with plat valid without expiration. Improvement Permit with site plan valid for sixty months. Authorization to Construct is valid for a period equal to that of Improvement Permit – not to exceed sixty months.

Signed: ____ date ____

Improvement Permit by: STEVE HEDRICK date 1-16-99

Authorization to Construct by: STEVE HEDRICK date 1-16-99

Installed by: A-1 BACKHOE

Operation Permit by: STEVE HEDRICK date 2-3-99

Existing System Inspection by: ____ date ____

HEALTH DEPT. COPY: WHITE INSPECTION COPY (FINAL): GREEN OWNER COPY (FINAL): YELLOW INSPECTION COPY (INITIAL): PINK OWNER COPY (INITIAL): GOLD