IREDELL COUNTY HEALTH DEPARTMENT

STATESVILLE 704-878-5305 MOORESVILLE 704-664-5281

IMPROVEMENT PERMIT / AUTHORIZATION TO CONSTRUCT / OPERATION PERMIT / EXISTING SYSTEM INSPECTION

PERMIT# 100887 PIN# 4840 96 7871 DATE 6-15-01

OWNER OR CONTRACTOR EDWARD FOX PHONE: Business Home (704) 876-4227

ADDRESS 516 JOSEY ROAD, OLIN, NC 28660

LOCATION US 21 N, TL JENNINGS ROAD, TR RED HAWK LANE, LOT #19 ON LEFT

SUBDIVISION GLEN ACRES BLOCK / SECTION LOT 19 LOT AREA 1.68 ACRES SITE CLASS PS DESIGN FLOW 360 L.T.A.R. 0.30 GPD/FT²

Septic Tank: 1000 Gallons; STB 825 Date 5-14-01
Pump Tank: Gallons; PT Date
Pump Make: Model Serial No.
Nitrification Field: No Fields 1 Square Feet 1200 Linear Feet 400
No Lines FOUR Trench Width 36" Max Trench Bottom Depth 36" Gravel Depth 12"

☑ New System ☐ Repair System Type: ☐ I ☐ II ☐ IV ☐ V ☐ VI
System Description: CONVENTIONAL GRAVITY
Repair System Description: CONV., GRAVITY/PUMP
Maintenance Agreement Required: ☐ Yes ☑ No
☐ Slab ☑ Crawl Space ☐ Basement w/plumbing ☐ Basement wo/plumbing


☐ House/Mod. Home No. Bedrooms 3
☑ Mobile Home No. Bathrooms 2
☐ Business No. Employees
☐ Other

Water Supply: ☑ Individual ☐ Public ☐ Community WELL

Comments/Conditions: KEEP SYSTEM MINIMUM 100 FEET FROM WELL

Comments/Conditions – poly lok filter installed

INITIAL SITE SKETCH

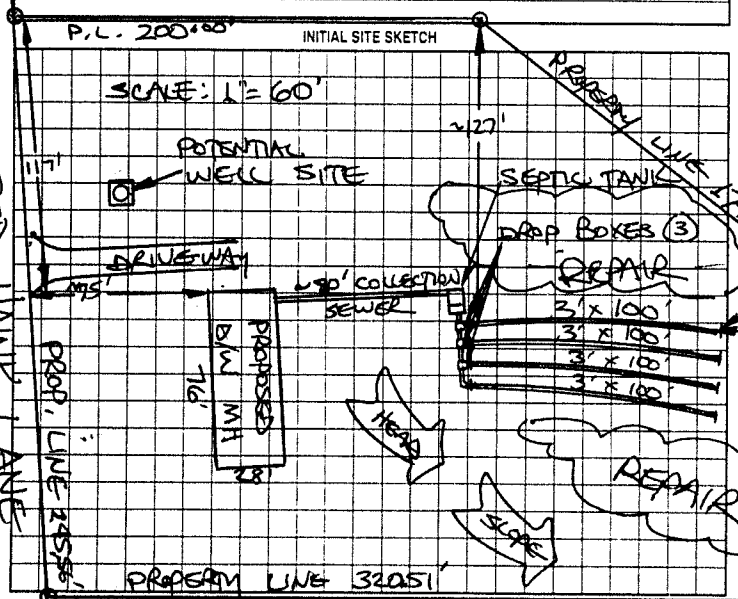

AS BUILT SKETCH

Installed as Per Site Sketch

RED HAWK LANE

Permit can be suspended or revoked if any false information is supplied toward securing the permit; any unauthorized changes are made to the site; any unauthorized changes are made in the installation of the system. Improvement Permit with plat valid without expiration. Improvement Permit with site plan valid for sixty months. Authorization to Construct is valid for a period equal to that of Improvement Permit – not to exceed sixty months.

Signed: + Edward Fox date 6-15-01 Installed by: Bobé Backhoe

Improvement Permit by: STEVE HERRICK date 6-15-01 Operation Permit by: William O. Johnson date 7/26/01

Authorization to Construct by: STEVE HERRICK date 6-15-01 Existing System Inspection by: date

HEALTH DEPT COPY: WHITE OWNER COPY (FINAL): YELLOW OWNER COPY (INITIAL): PINK