IREDELL COUNTY HEALTH DEPARTMENT

STATESVILLE 704-878-5305 MOORESVILLE 704-664-5281

IMPROVEMENT PERMIT / AUTHORIZATION TO CONSTRUCT / OPERATION PERMIT / EXISTING SYSTEM INSPECTION

PERMIT# 093672 PIN# 4841 00 6802 DATE 01-23-01

OWNER OR CONTRACTOR JOSEPH ALAN ADAMS PHONE: Business Home 704/876/3754

ADDRESS 507 BLACKWELDER RD STATESVILLE NC 28625

LOCATION NORTH ON JENNINGS, L ON MT VERNON CHURCH RD, CROSS CREEK ON LEFT

SUBDIVISION BLOCK / SECTION LOT LOT AREA .5 ACRE SITE CLASS. PS DESIGN FLOW 360gpd L.T.A.R. .3gpd/ft2

Septic Tank: 1000 Gallons: STB 1600 Date 3-26-01

Pump Tank: Gallons: PT Date

Pump Make: Model Serial No

Nitrification Field: No Fields 1 Square Feet EQ to 1200' Linear Feet 300'

No Lines 4 Trench Width 36" Max Trench Bottom Depth 36"

X New System ☐ Repair System Type: I, II, III, IV, V, VI

System Description: CONV 25% REDUCTION

Repair System Description: CONV PANEL/TRENCH DESIGN

Maintenance Agreement Required: ☐ Yes X No

Gravel Depth N/A ☐ Slab X Crawl Space ☐ Basement w/plumbing ☐ Basement wo/plumbing

☐ House/Mod. Home No. Bedrooms 3

X Mobile Home No. Bathrooms 2

☐ Business No. Employees


☐ Other

Water Supply: ☐ Individual X Public ☐ Community

Comments/Conditions: ① Fill in & pack ditch & keep lower line at least 10' away ② KEEP system 5' off house & 10' off property lines ③ Redirect ditch down property line or do away with totally.

Comments/Conditions: ④ USE 4 DROP BOXES ⑤ INSTALL LINES ON CONTOUR ⑥ USE CHAMBERS OR HDES SECTIONS

INITIAL SITE SKETCH

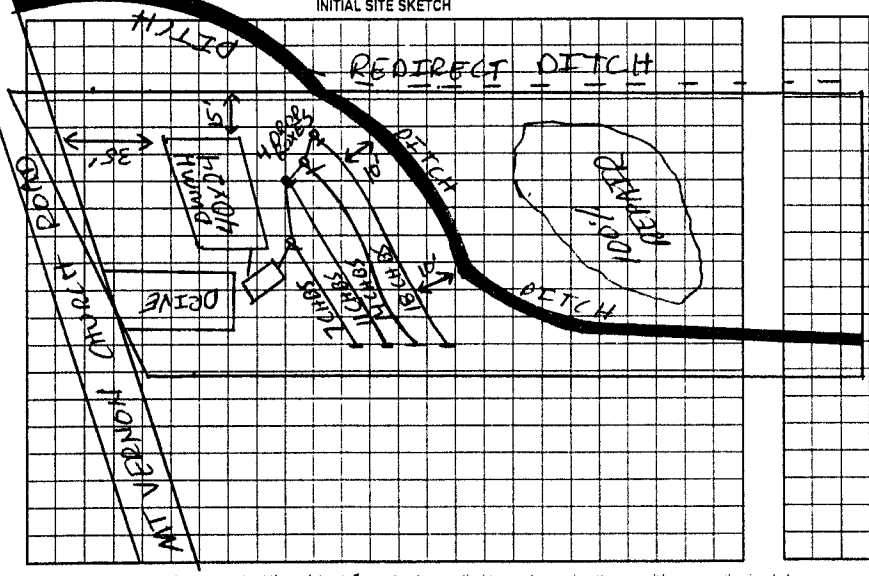

AS BUILT SKETCH

SYSTEM INSTALLED ACCORDING TO INITAL SITE SKETCH

Permit can be suspended or revoked if any false information is supplied toward securing the permit/any unauthorized changes are made to the site; any unauthorized changes are made in the installation of the system. Improvement Permit with plat valid without expiration. Improvement Permit with site plan valid for sixty months. Authorization to Construct is valid for a period equal to that of Improvement Permit – not to exceed sixty months.

Signed: Joseph Alan Adams date 2-1-01 Installed by: RYAN BYERS / DANNY LAMBERT

Improvement Permit by: [signature] EST date 01-23-01 Operation Permit by: STEVE HEDRICK date 5-29-01

Authorization to Construct by: [signature] EST date 01-23-01 Existing System Inspection by: date

HEALTH DEPT. COPY WHITE OWNER COPY (FINAL) YELLOW OWNER COPY (INITIAL) PINK