IREDELL COUNTY HEALTH DEPARTMENT

STATESVILLE 704-878-5305 (C1) MOORESVILLE 704-664-5281

IMPROVEMENT PERMIT / AUTHORIZATION TO CONSTRUCT / OPERATION PERMIT / EXISTING SYSTEM INSPECTION

PERMIT# 087953 PIN# 4841 14 0886 (PART) DATE 3-2-00

OWNER OR CONTRACTOR HERBERT REID PHONE: Business Home 876-6307

ADDRESS 160 ESTATE DRIVE STATESVILLE NC 28625

LOCATION US 21 N, TL JENNINGS RD, TL WEISNER RD, TL CURRENT ROAD, 0.5 MILE ON RIGHT ~1000' BACK

SUBDIVISION BLOCK / SECTION LOT LOT AREA 10 ACRES SITE CLASS PS DESIGN FLOW 480 L.T.A.R. 0.30 GPD/FT²

Septic Tank: 1000 Gallons; STB 760 Date 10-27-01
Pump Tank: Gallons; PT Date
Pump Make: Model Serial No.
Nitrification Field: No Fields 1 Square Feet 1600 Linear Feet 540
No Lines SIX Trench Width 36" Max Trench Bottom Depth 36" Gravel Depth 12"

☒ New System ☐ Repair System Type: I (II) III, IV, V, VI
System Description: CONVENTIONAL GRAVITY
Repair System Description: CONV. GRAVITY
Maintenance Agreement Required: ☐ Yes ☒ No
☐ Slab ☒ Crawl Space ☐ Basement w/plumbing ☐ Basement wo/plumbing


~~☐ House/Mod. Home~~ No. Bedrooms 4
~~☐ Mobile Home~~ No. Bathrooms 2½
☐ Business No. Employees
☐ Other

Water Supply: ☒ Individual ☐ Public ☐ Community
WELL


Comments:/Conditions: ① KEEP SYSTEM MINIMUM 100 FEET FROM WELL ② USE ONE FLOW DIVIDER TEE TO ACHIEVE EQUAL DISTRIBUTION INTO EACH OF TWO SERIES OF DROP BOXES.

Comments:/Conditions: SEPTIC TANK WITH RISERS INSTALLED USING "PABEL" FILTER

INITIAL SITE SKETCH ~ SCALE: 1"=50'

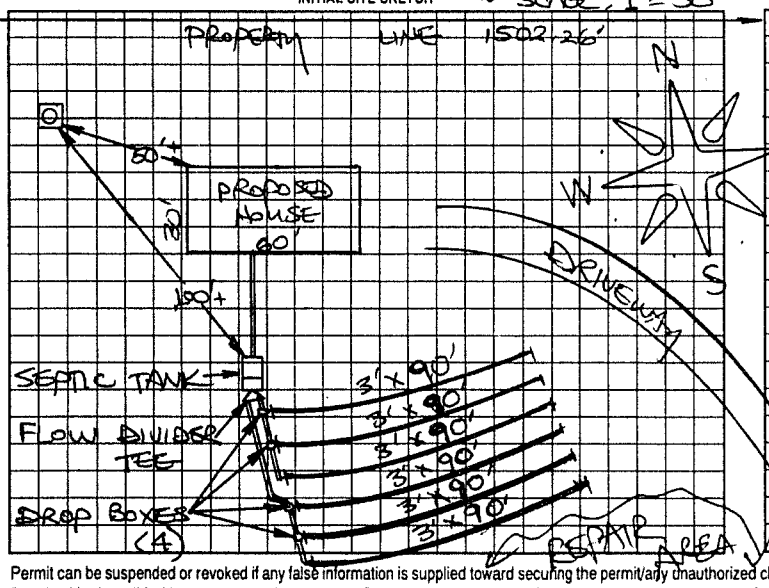

AS BUILT SKETCH SCALE: 1"=50'

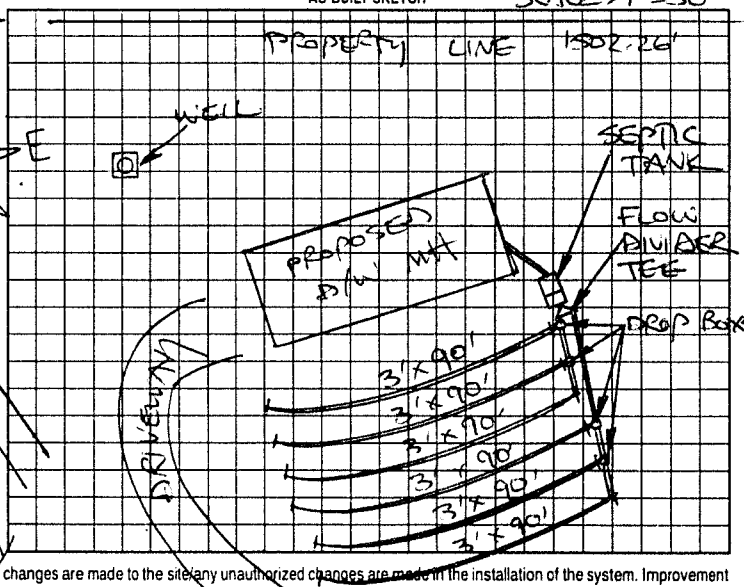

Permit can be suspended or revoked if any false information is supplied toward securing the permit/any unauthorized changes are made to the site/any unauthorized changes are made in the installation of the system. Improvement Permit with plat valid without expiration. Improvement Permit with site plan valid for sixty months. Authorization to Construct is valid for a period equal to that of Improvement Permit – not to exceed sixty months.

Signed: Sandra Reid date 3-3-00 Installed by: BRENT GALLIHER

Improvement Permit by: STEVE HEDRICK date 3-2-00 Operation Permit by: STEVE HEDRICK date 2-19-02

Authorization to Construct by: STEVE HEDRICK date 3-2-00 Existing System Inspection by: date

HEALTH DEPT. COPY: WHITE OWNER COPY (FINAL): YELLOW OWNER COPY (INITIAL): PINK