IREDELL COUNTY HEALTH DEPARTMENT

STATESVILLE 704-878-5305 MOORESVILLE 704-664-5281

IMPROVEMENT PERMIT / AUTHORIZATION TO CONSTRUCT / OPERATION PERMIT / EXISTING SYSTEM INSPECTION

PERMIT# 076888 PIN# 4841 08 9864 DATE 11-17-98

OWNER OR CONTRACTOR TONY WILBANKS PHONE: Business 878-5305 Home 528-3320

ADDRESS 236 BENNETT ROAD STONY POINT NC 28678

LOCATION JENNINGS ROAD TO MT. VERNON CHURCH ROAD, TR/ EUPEPTIC SPRINGS RD TR CLIFFORD RD LOT ON LEFT

SUBDIVISION BLOCK / SECTION LOT LOT AREA 2.006 ACRES SITE CLASS PS DESIGN FLOW 360 L.T.A.R. 10,30 GPD/FT2

Septic Tank 1000 Gallons STB 1012 Date 9-15-98

Pump Tank Gallons PT Date

Pump Make Model Pump No.

Notification Paid: No Field 1 Square Feet 1200 Lin. Feet 400

No. Lines FIVE Trench Depth 36" Bottom Depth 24"

Gravel Depth 12"

✓ New System Repair System Type: I II III IV V VI

System Description CONVENTIONAL GRAVITY

Repair System Description LOW PRESSURE PIPE

Mechanical Apparatus Required: Yes ✓ No

Slope: ✓ Level Slope Basement w/plumbing Basement w/o plumbing

House/Mod. Home ✓ Mobile Home Business

No. Bedrooms 3 No. Bathrooms 2 No. Employees

Water Supply: ☐ Individual ☐ Public ☐ Community WELL


Comments/Conditions: INSTALL LINES ON CONTOUR AS FLAGGED, NO DEEPER THAN 24 INCHES

Comments/Restrictions: SYSTEM INSTALLED ACCORDING TO INITIAL SITE SKETCH.

INITIAL SITE SKETCH

SCALE: 1"=50'

AS BUILT SKETCH

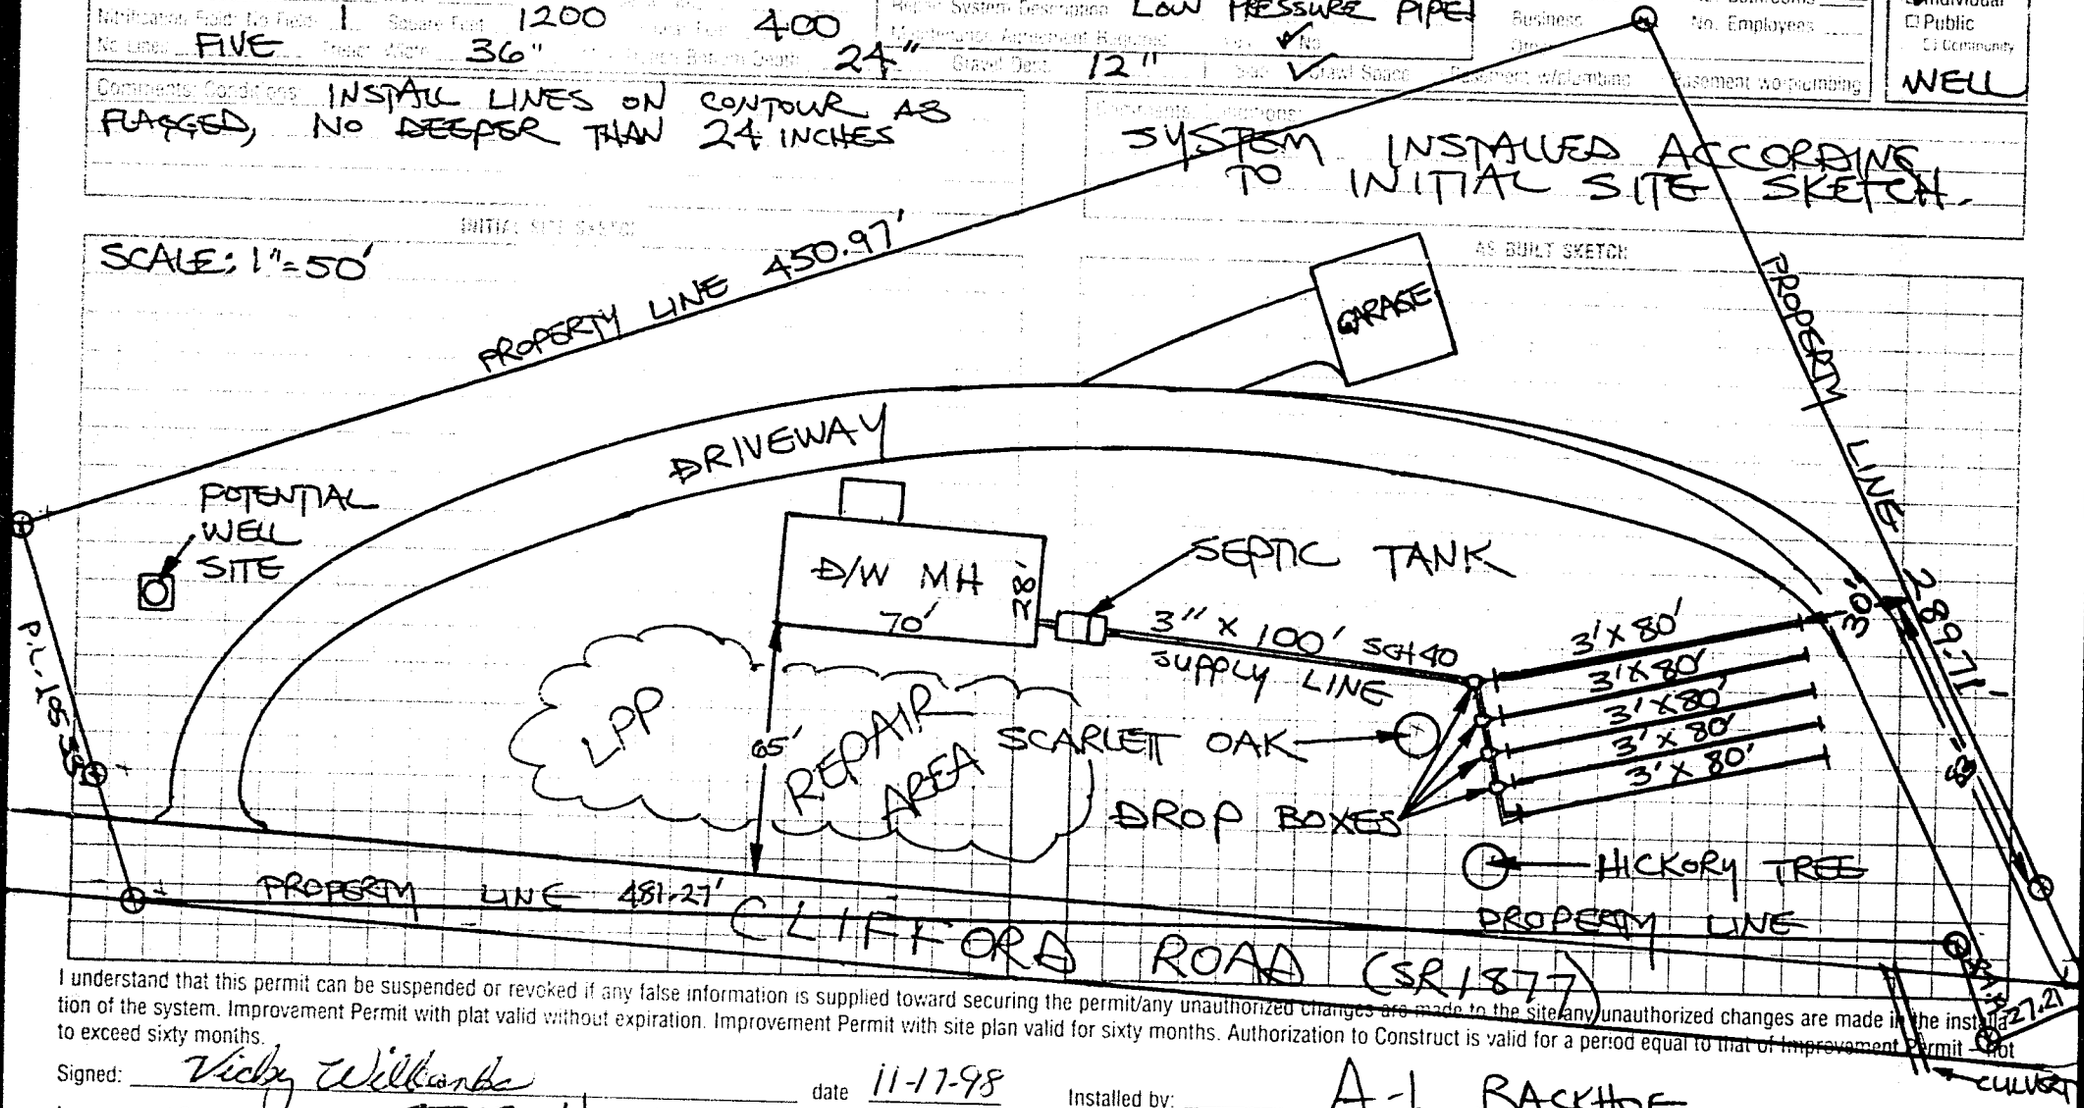

I understand that this permit can be suspended or revoked if any false information is supplied toward securing the permit/any unauthorized changes are made to the site/any unauthorized changes are made in the installation of the system. Improvement Permit with plat valid without expiration. Improvement Permit with site plan valid for sixty months. Authorization to Construct is valid for a period equal to that of Improvement Permit not to exceed sixty months.

Signed: Vicky Williamson date 11-17-98

Improvement Permit by: STEVE HEDRICK date 11-17-98

Authorization to Construct by: STEVE HEDRICK date 11-17-98

Installed by: A-1 BACKHOE

Operation Permit by: STEVE HEDRICK date 11-20-98

Existing System Inspection by date

HEALTH DEPT COPY WHITE OWNER COPY (FINAL) GREEN OWNER COPY (FINAL) YELLOW INSPECTION COPY (INITIAL) PINK OWNER COPY (INITIAL) GOLD