IREDELL COUNTY HEALTH DEPARTMENT

STATESVILLE 704-878-5305 (CV) MOORESVILLE 704-664-5281

IMPROVEMENT PERMIT / AUTHORIZATION TO CONSTRUCT / OPERATION PERMIT / EXISTING SYSTEM INSPECTION

PERMIT# 103312 PIN# 4841-14-6805 DATE 11-27-01

OWNER OR CONTRACTOR JOSE & APRIL REYES PHONE: Business (704) 876-0096 Home (704) 592-2125

ADDRESS P.O. Box 7771, STATESVILLE, NC 28687

LOCATION NC115N, TR FRIENDSHIP RD, TL MT. VERNON RD, TL EUREPTIC SPRINGS RD, TR CURRENT RD 0.5 MILE ON LEFT

SUBDIVISION _____ BLOCK / SECTION _____ LOT _____ LOT AREA 9.24 Acres SITE CLASS. PS DESIGN FLOW 360 L.T.A.R. 0.30 GAD/FT²

Septic Tank: 1000 Gallons; STB 1007 Date 11-7-01

Pump Tank: _____ Gallons; PT _____ Date _____

Pump Make: _____ Model _____ Serial No. _____

Nitrification Field: No Fields 1 Square Feet EQ. TO 1200 Linear Feet 300

No Lines SIX Trench Width 36" Max Trench Bottom Depth 36" Gravel Depth N/A

☑ New System ☐ Repair System Type: I. II. (III) IV. V. VI

System Description: 25% REDUCTION, GRAVITY

Repair System Description: 25% REDUCTION, PUMP

Maintenance Agreement Required: ☐ Yes ☑ No

☐ House/Mod. Home No. Bedrooms 3

☑ Mobile Home No. Bathrooms 2

☐ Business No. Employees ____

☐ Other _____

☐ Slab ☑ Crawl Space ☐ Basement w/plumbing ☐ Basement wo/plumbing


Water Supply: ☑ Individual ☐ Public ☐ Community

WELL


Comments/Conditions: ① INSTALL 45 CHAMBERS OR 30 HDS SECTIONS ON CONTOUR AS SHOWN. ② KEEP SYSTEM MINIMUM 100 FEET FROM WELL

Comments/Conditions: SEPTIC TANK WITH MARKER INSTALLED USING "FABRIC" FILTER

INITIAL SITE SKETCH

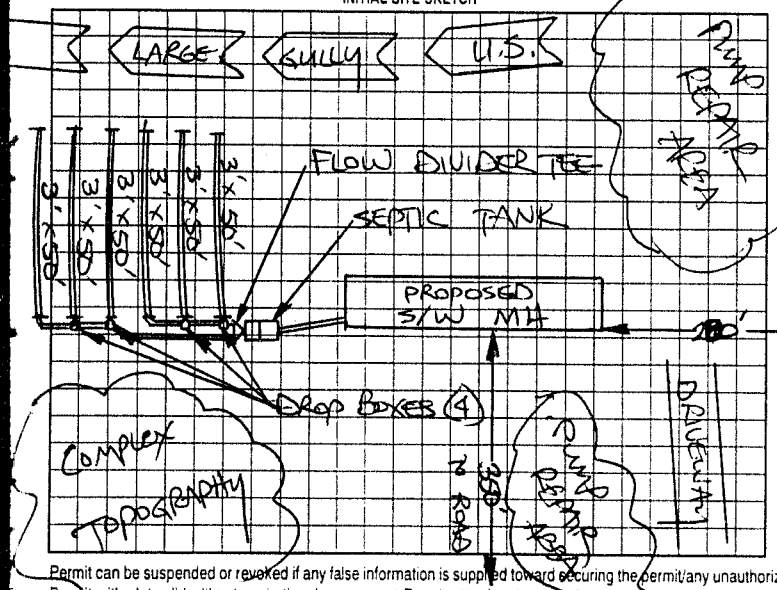

AS BUILT SKETCH

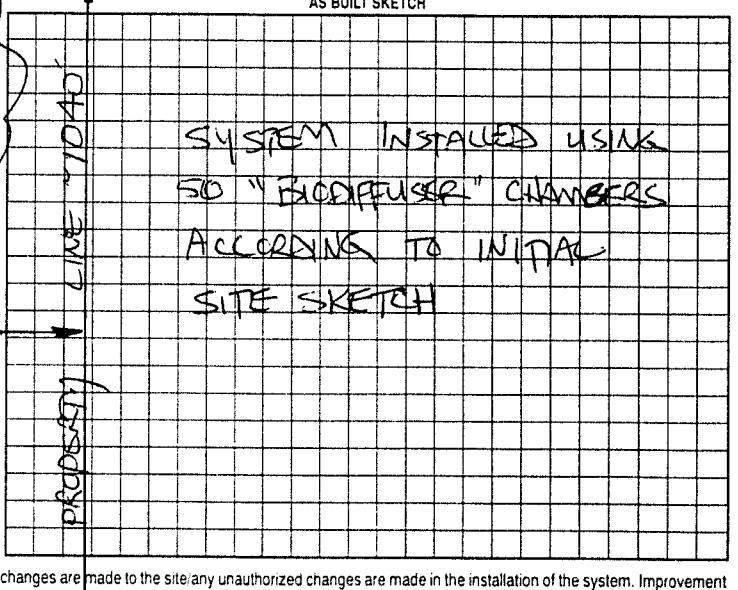

Permit can be suspended or revoked if any false information is supplied toward securing the permit/any unauthorized changes are made to the site/any unauthorized changes are made in the installation of the system. Improvement Permit with plat valid without expiration. Improvement Permit with site plan valid for sixty months. Authorization to Construct is valid for a period equal to that of Improvement Permit – not to exceed sixty months.

Signed: ~~X~~ April Reyes 12-5-01 date 12-5-01

Improvement Permit by: STEVE HEDRICK date 11-27-01

Authorization to Construct by: STEVE HEDRICK date 11-27-01

Installed by: A & C GRADING

Operation Permit by: STEVE HEDRICK date 1-16-02

Existing System Inspection by: _____ date _____

HEALTH DEPT. COPY WHITE OWNER COPY (FINAL) YELLOW OWNER COPY (INITIAL) PINK