IREDELL COUNTY HEALTH DEPARTMENT

STATESVILLE 704-878-5305 MOORESVILLE 704-664-5281

IMPROVEMENT PERMIT / AUTHORIZATION TO CONSTRUCT / OPERATION PERMIT / EXISTING SYSTEM INSPECTION

PERMIT# 083945 PIN# 4841 14 0886 (PT) DATE 10-1-99

OWNER OR CONTRACTOR JASON WOOD PHONE. Business 528-9449 Home (828) 478-5068

ADDRESS 7746 SHERRILS FORD ROAD, SHERRILS FORD, NC 28673

LOCATION US 21 NORTH, TL JENNINGS RD, TL WEISNER RD, TL CURRENT RD, 0.5 MILE ON RIGHT AT CORREY LANE

SUBDIVISION NORTHPOINT BLOCK / SECTION ____ LOT 4 LOT AREA 1.082 ACRE SITE CLASS P3 DESIGN FLOW 360 L.T.A.R. 0.35 GPD/FT²

Septic Tank: 1000 Gallons: STB 1012 Date 8-17-99

Pump Tank: ____ Gallons: PT ____ Date ____

Pump Make: ____ Model ____ Serial No ____

Nitrification Field: No Fields 1 Square Feet 1035 Linear Feet 258

No Lines FOUR Trench Width 36" Max Trench Bottom Depth 36"

(✓) New System ( ) Repair System Type: I, II, (III), IV, V, VI

System Description: 25% REDUCTION GRAVITY

Repair System Description: 25% REDUCTION GRAVITY

Maintenance Agreement Required: ( ) Yes (✓) No

~~Gravel~~ Depth SAND 6" ( ) Slab (✓) Crawl Space ( ) Basement w/plumbing ( ) Basement wo/plumbing

( ) House/Mod Home No. Bedrooms 3

(✓) Mobile Home No. Bathrooms 2

( ) Business No. Employees ____

( ) Other ____


Water Supply: (✓) Individual ( ) Public ( ) Community WELL

Comments/Conditions ① KEEP SYSTEM MINIMUM 100' FROM WELL


② INSTALL 43 CHAMBERS OR 26 HDS SECTIONS.

Comments Conditions SEPTIC TANK WITH MARKER AND RISERS INSTALLED USING "POLYLOK" FILTER

INITIAL SITE SKETCH

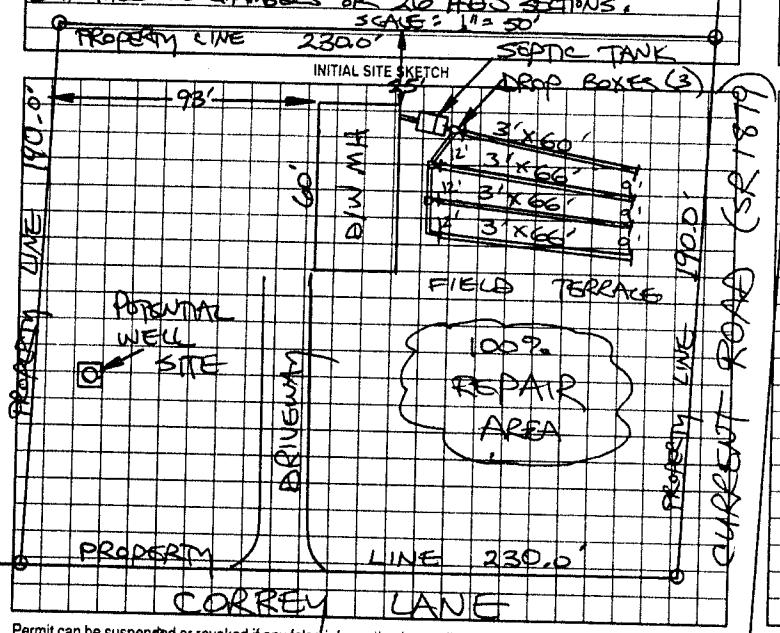

AS BUILT SKETCH

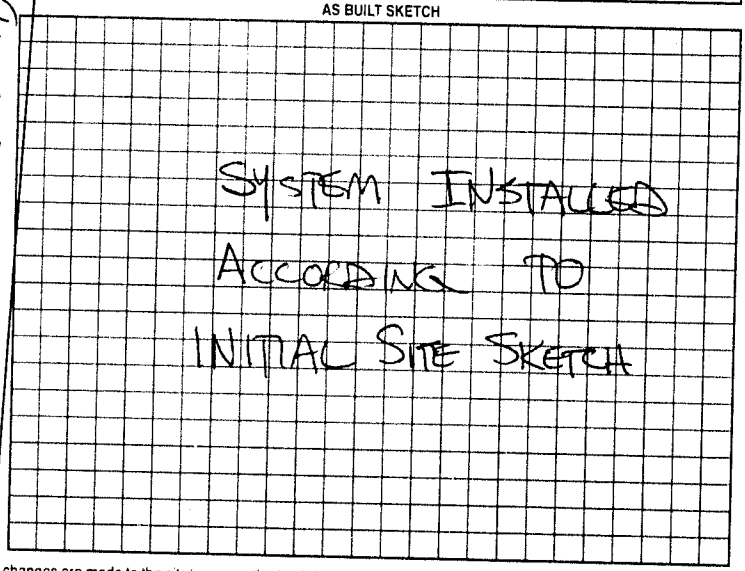

Permit can be suspended or revoked if any false information is supplied toward securing the permit/any unauthorized changes are made to the site/any unauthorized changes are made in the installation of the system. Improvement Permit with plat valid without expiration. Improvement Permit with site plan valid for sixty months. Authorization to Construct is valid for a period equal to that of Improvement Permit - not to exceed sixty months.

Signed: + Jason Wood date 10-9-99

Improvement Permit by: STEVE HEDRICK date 10-1-99

Authorization to Construct by: STEVE HEDRICK date 10-1-99

Installed by: A-1 BACKHOE

Operation Permit by: STEVE HEDRICK date 11-4-99

Existing System Inspection by: ____ date ____

HEALTH DEPT. COPY WHITE OWNER COPY (FINAL) YELLOW OWNER COPY (INITIAL) PINK