IREDELL COUNTY HEALTH DEPARTMENT

STATESVILLE 704-878-5305 MOORESVILLE 704-664-5281

IMPROVEMENT PERMIT / AUTHORIZATION TO CONSTRUCT / OPERATION PERMIT / EXISTING SYSTEM INSPECTION

PERMIT# 81025 PIN# 4841180819 DATE 5-14-99

OWNER OR CONTRACTOR Barry Mitchell PHONE: Business Home 8764768

ADDRESS 107 Pineview Ct Statesville

LOCATION Fenning Rd TL Wiesner TR Clifford 3/8 mi Rt.

SUBDIVISION Whisper Brook BLOCK / SECTION LOT 3 LOT AREA 1.59 SITE CLASS P5 DESIGN FLOW [redacted] 480 L.T.A.R. .3

Septic Tank: 1000 Gallons; STB 620 Date 4-5-99
Pump Tank: Gallons; PT Date
Pump Make: Model Serial No.
Nitrification Field: No Fields 1 Square Feet 1600 Linear Feet 533
No Lines 5 Trench Width 36" Max Trench Bottom Depth 36" Gravel Depth 12"

☑ New System ☐ Repair System Type: ☐ I, II, III, IV, V, VI
System Description: Conv. Gravity
Repair System Description: " "
Maintenance Agreement Required: ☐ Yes ☑ No
☐ Slab ☑ Crawl Space ☐ Basement w/plumbing ☐ Basement wo/plumbing


☑ House/Mod. Home No. Bedrooms 4
☑ Mobile Home No. Bathrooms 2
☐ Business No Employees
☐ Other

Water Supply: ☑ Individual ☐ Public ☐ Community


Comments/Conditions:

Comments/Conditions SEPTIC TANK W/ RISER & POLYLOK FILTER INSTALLED. 990

INITIAL SITE SKETCH

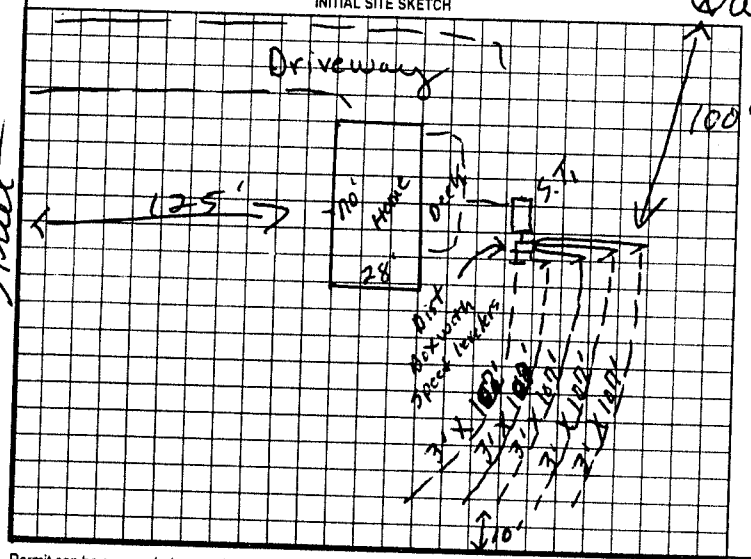

AS BUILT SKETCH

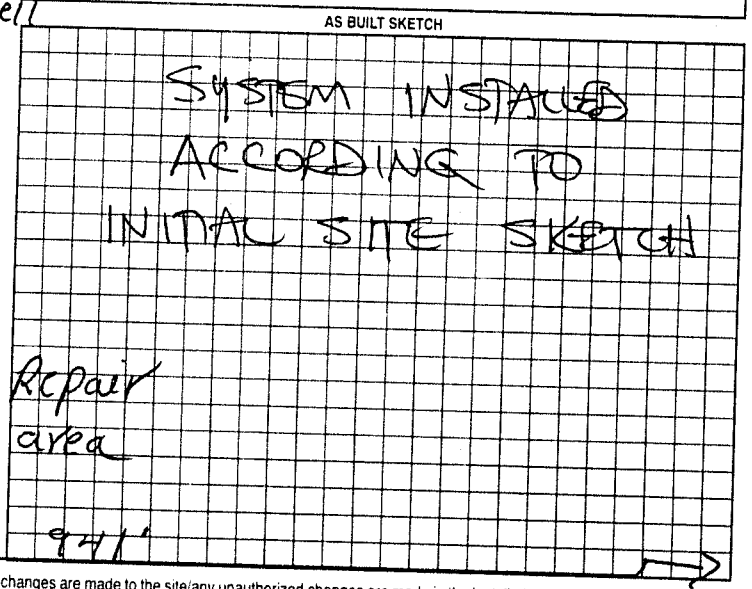

Permit can be suspended or revoked if any false information is supplied toward securing the permit/any unauthorized changes are made to the site/any unauthorized changes are made in the installation of the system. Improvement Permit with plat valid without expiration. Improvement Permit with site plan valid for sixty months. Authorization to Construct is valid for a period equal to that of Improvement Permit – not to exceed sixty months.

Signed: X - Barry M Mitchell date 5-14-99 Installed by: KENNY MADISON

Improvement Permit by: P. C. Moore date 5-14-99 Operation Permit by: STEVE HENDRICK date 6-10-99

Authorization to Construct by: P. C. Moore date 5-14-99 Existing System Inspection by: date

HEALTH DEPT. COPY WHITE OWNER COPY (FINAL) YELLOW OWNER COPY (INITIAL) PINK