IREDELL COUNTY HEALTH DEPARTMENT

Statesville Office (704) 878-5305 Mooresville Office (704) 660-3625 PERMIT # 211084

IMPROVEMENT PERMIT / AUTHORIZATION TO CONSTRUCT / OPERATION PERMIT / EXISTING SYSTEM

PIN # ~~4841-68-1322~~ 4841-68-1322 25.4865

APPLICANT: MOORE FIELD BUILDERS, INC APPLICANT ADDRESS: 1516 MOCKSVILLE Highway Statesville, NC 28625

SITE ADDRESS: 291 WEISNER RD PHONE: 7048806620 ALT. PHONE: N/A

SITE DIRECTIONS: 21 North (L) Jennings (L) Weisner (L) ATBOX # 291


SUBDIVISION: N/A SECTION: N/A LOT # N/A LOT AREA: 6.633 ACRES DESIGN FLOW: 360 L.T.A.R.: .3

Septic Tank	1000 (gal)	STB	1012-1000	Date	4-15-15	[X] New System [ ] Repair [ ] Expansion	System Type: I II (III) IV V VI	[X] Residence	No. Bedrooms 3
Pump Tank	(gal)	PT		Date		System Description:	GRAVITY 25% REDUCTION	[ ] Business	No. Persons 6
Pump Make		Model		Serial #		Repair System Description:	SAME	[ ] Other	No. Employees
# Nitrification Fields		# Lines	2	Linear Ft:	300'	Maintenance Agreement Required:	[ ] YES [X] NO	[ ] Slab	[ ] Crawl Space
Trench Width	36"	Max. Trench Bottom Depth	*29" *	Gravel Depth	N/A	[X] GRAVITY	[ ] PRESSURE	[X] Basement w/plumbing	[ ] Basement w/o plumbing


Water Supply: [ ] Private [ ] Public [X] Community

Comments / Conditions: (1) TANK IS 40' from HOUSE CORNER DUE TO BASEMENT CUT. KEEP FALL TO TANK & NOTE Shallow TRENCH BOTTOM DEPTH. OVER Digging may void permit. * (2) Note maximum 29" Trench bottom depth due to rock. (3) Install lines on contours as flagged (4) Maintain SETBACKS (5) Consulted with BUILDER on how critical basement cut is on this lot due to shallow placement and keep required fall on supply lines.

INITIAL SITE SKETCH

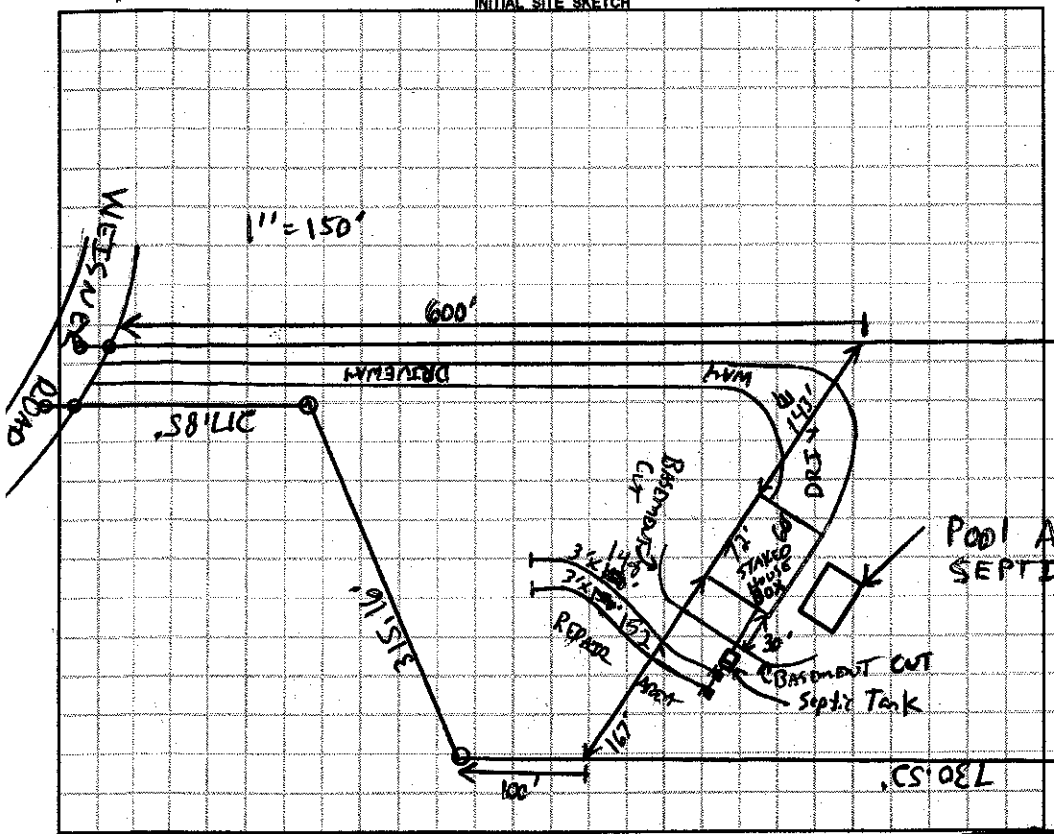

AS BUILT SKETCH

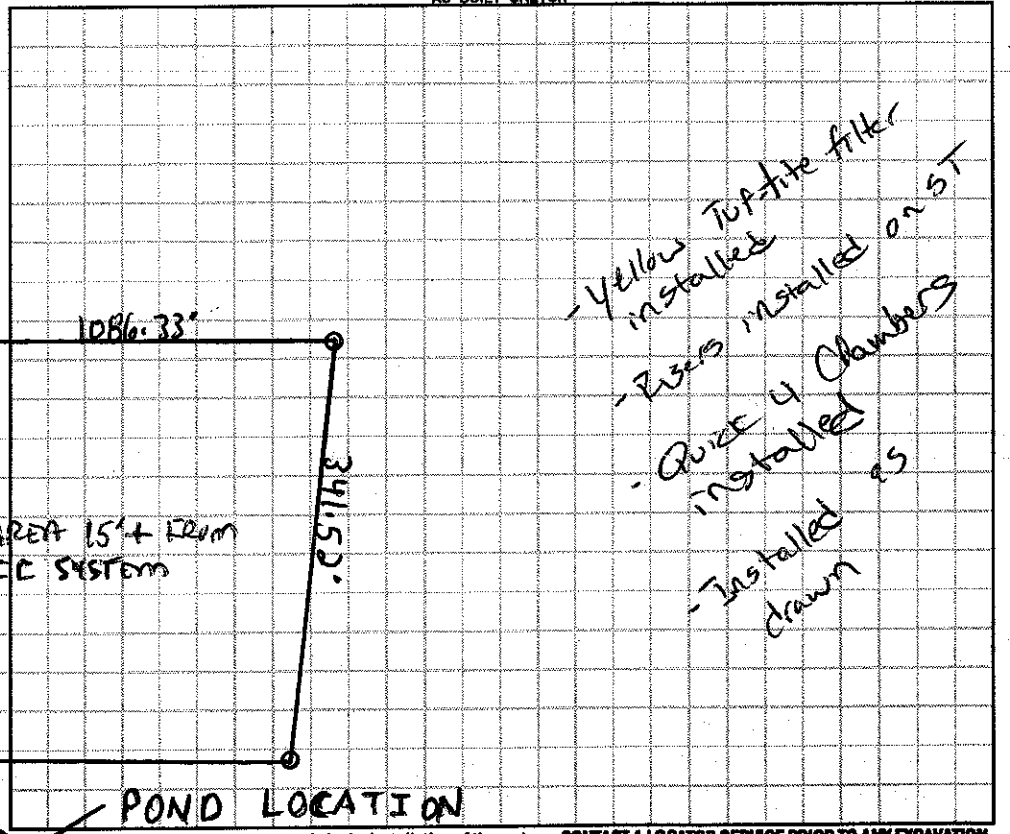

Permit can be suspended or revoked if any false information is supplied toward securing the permit / any unauthorized changes are made to the site / any unauthorized changes are made in the installation of the system. **CONTACT A LOCATOR SERVICE PRIOR TO ANY EXCAVATION**

[ ] **IMPROVEMENT PERMIT** *with plat valid without expiration.* [X] **IMPROVEMENT PERMIT** *with site plan valid for 60 mos.* [X] **AUTHORIZATION TO CONSTRUCT** *valid for period equal to IMPROVEMENT PERMIT--not to exceed 60 mo.*

Owner / Applicant Signature: Matthew A Moore Date: 8-21-2015 Installed by: Steve Jordan

IMPROVEMENT PERMIT by: Mark Reitz Date: 7-2-15 OPERATION PERMIT by: Justin Henderson Date: 3-9-16

AUTHORIZATION TO CONSTRUCT by: Mark Reitz Date: 7-2-15 Existing System Inspected by: Date:

Health Dept. Copy - WHITE Applicant (Final Approval) - YELLOW Applicant (Conditional Approval) - PINK