IREDELL COUNTY HEALTH DEPARTMENT

Statesville Phone TR 3-7271 Mooresville Phone NO 3-1271

PERMIT TO INSTALL SEPTIC TANK

Permit NO. 74 Permit Date 1-26 1972

Owner Mrs Joyce Address Olin Rt.

Installed By Sam Poovey Address Mocksville Rt 1


Location of Property Follow Jerusalem rd to community center Turn left go to next rd. (4) & 15 Section left 1st house on left.

Tank		Capacity		Length of Lines		Fixtures	
Block	( )	1000	( )	225'	(✓)	No. of Baths	(1)
Precast	(✓)	1250	( )	250'	( )	Dishwasher	( )
		1500	( )	Other		Garbage Grdr.	( )
		Other				Other	

NOTIFY HEALTH DEPARTMENT AT LEAST EIGHT HOURS BEFORE TANK IS TO BE INSPECTED.

Final Inspection 1-26 1972 Approved (✓) Disapproved ( )

Remarks

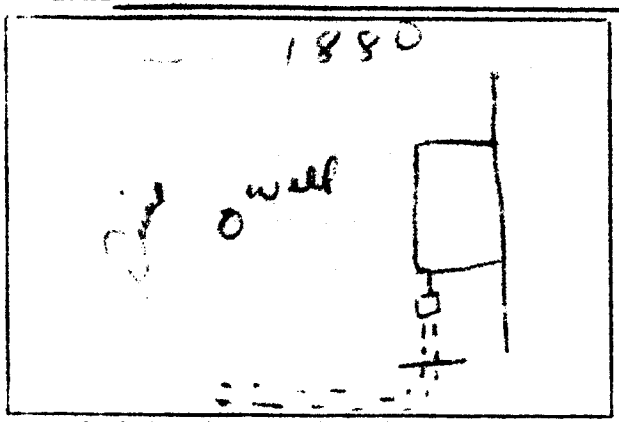

Sketch of Installation

Not checked -

Sanitarian