IREDELL COUNTY HEALTH DEPARTMENT

Statesville Office (704) 878-5305 Mooresville Office (704) 660-3625 PERMIT # 216513

IMPROVEMENT PERMIT / AUTHORIZATION TO CONSTRUCT / OPERATION PERMIT / EXISTING SYSTEM

PIN # 4841415736

APPLICANT: Josh Taylor APPLICANT ADDRESS: 187 Spring Valley Ct.

SITE ADDRESS: 190 Mt. Vernon Rd. PHONE: 336-971-6449 ALT. PHONE: 704-880-5946

SITE DIRECTIONS: Hwy 21N TL Jennings Rd TL Mt. Vernon Rd.

SUBDIVISION: N/A SECTION: N/A LOT # N/A LOT AREA: 2.92 acres DESIGN FLOW: 360gpd L.T.A.R.: 0.03

Septic Tank 1000 (gal) STB 760-1000 Date 2-1
Pump Tank (gal) PT Date
Pump Make Model Serial #
Nitrification Fields 1 # Lines 3 Linear Ft: 300
Trench Width 36" Max. Trench Bottom Depth 32" Gravel Depth N/A


☑ New System ☐ Repair ☐ Expansion System Type: I II (III) IV V VI
System Description: 25% Reduction
Repair System Description: 25% Reduction
Maintenance Agreement Required: ☐ YES ☑ NO
☑ GRAVITY ☐ PRESSURE

☑ Residence No. Bedrooms 3
☐ Business No. Persons 6
☐ Other No. Employees
☐ Slab ☑ Crawl Space
☐ Basement w/plumbing ☐ Basement w/o plumbing


Water Supply: ☐ Private ☑ Public ☐ Community

Comments / Conditions: Install a 25% Reduction system on contour with serial distribution. DO NOT CUT FOR HOUSE PAD

INITIAL SITE SKETCH

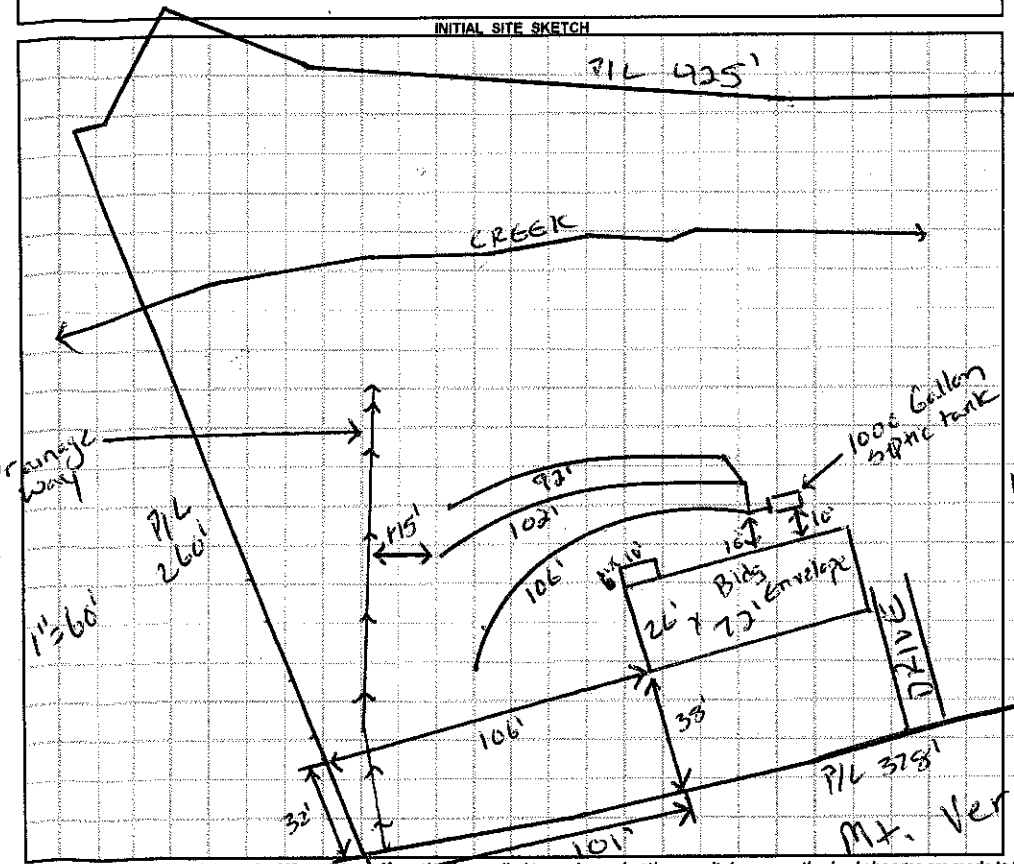

AS BUILT SKETCH

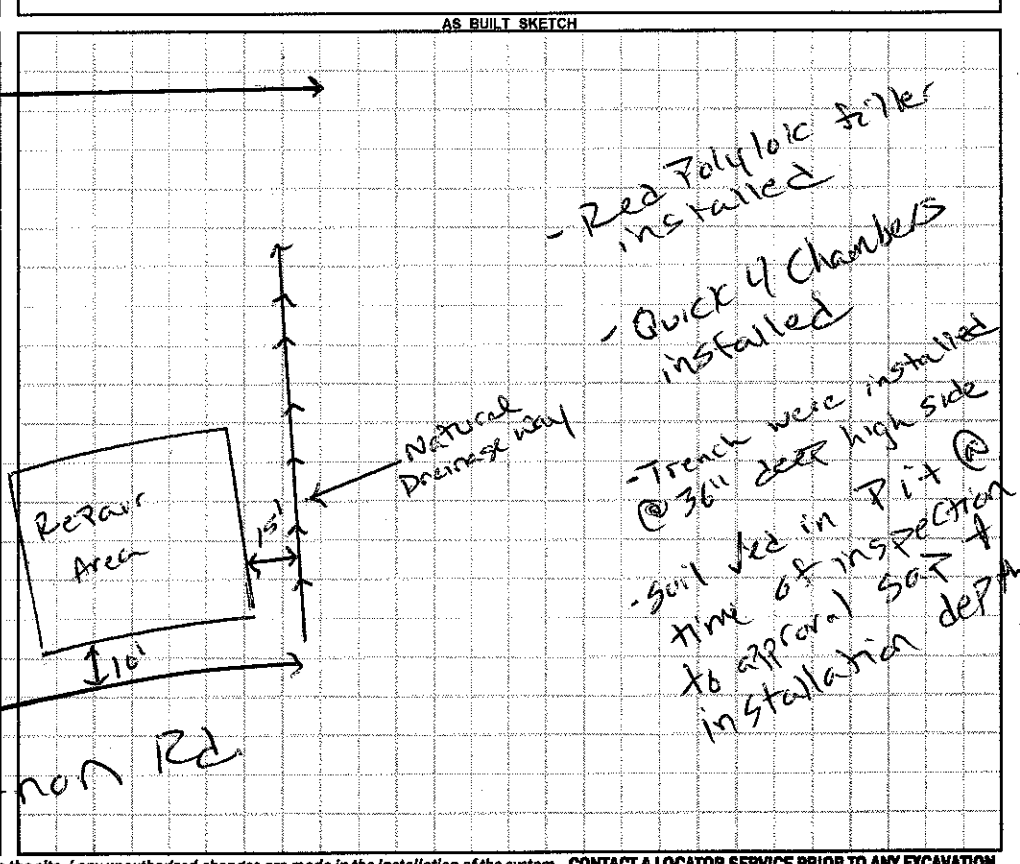

Permit can be suspended or revoked if any false information is supplied toward securing the permit / any unauthorized changes are made to the site / any unauthorized changes are made in the installation of the system. **CONTACT A LOCATOR SERVICE PRIOR TO ANY EXCAVATION**

☐ **IMPROVEMENT PERMIT** *with plat valid without expiration.* ☑ **IMPROVEMENT PERMIT** *with site plan valid for 60 mos.* ☑ **AUTHORIZATION TO CONSTRUCT** *valid for period equal to IMPROVEMENT PERMIT--not to exceed 60 mo.*

Owner / Applicant Signature: Date: Installed by: A1 Backhoe

IMPROVEMENT PERMIT by: Justin Henderson Date: 3-18-16 OPERATION PERMIT by: Justin Henderson Date: 5-16-16

AUTHORIZATION TO CONSTRUCT by: Justin Henderson Date: 3-18-16 Existing System Inspected by: Date:

Health Dept. Copy - WHITE Applicant (Final Approval) - YELLOW Applicant (Conditional Approval) - PINK