48362

IREDELL COUNTY HEALTH DEPARTMENT

STATESVILLE 704-878-5305 MOORESVILLE 704-664-5281

IMPROVEMENT PERMIT / CERTIFICATE OF COMPLETION / OPERATION PERMIT / EXISTING SYSTEM INSPECTION

PROPERTY DESCRIPTION NO. 16756 DATE 8/16/93 TAX MAP NO. 16D-A-23

OWNER OR CONTRACTOR CALVIN WESTMORELAND PHONE: Business Home 876-4841

ADDRESS RT. 1 BOX 276 OLIN, NC 28660

LOCATION US 21 N, TL JENNINGS RD, 1ST HOUSE ON (L) PAST NORTH IREDELL MIDDLE SCH.

SUBDIVISION BLOCK / SECTION LOT LOT AREA ~80 AC SITE CLASS. PS L.T.A.R. 0.30 GPD/FT

Water Supply: ☐ Individual ☐ Community ☑ Public

Septic Tank: 1000 Gallons; STB 358 Date 6/29/93

Pump Tank: Gallons; PT Date

Nitrification Field: No Fields 1 Square Feet 1200 Linear Feet 400

No Lines 3 Trench Width 36" Trench Depth 18-30" Gravel Depth 12"

☑ New System ☐ Repair System Type: I, II, III, IV, V, VI

System Description: CONV. GRAVITY

Repair System Description: CONV. GRAVITY

Maintenance Agreement Required: ☐ Yes ☑ No

☑ House/Mod. Home No. Bedrooms 3 Garbage Disposal: ☐ Yes ☑ No

☐ Mobile Home No. Bathrooms 3½ Auto. Dishwasher: ☐ Yes ☐ No


☐ Business No. Employees Auto. Washing Machine: ☑ Yes ☐ No

☐ Other Other

☐ Slab ☑ Crawl Space ☐ Basement w/plumbing ☐ Basement wo/plumbing

Comments (1) KEEP SYSTEM MINIMUM 5' FROM HOUSE, 10' FROM PROPERTY LINE, 100' FROM ANY WELL (2) INSTALL LINES ON CONTOUR, NO DEEPER THAN 30", 9' APART ON CENTER.

INITIAL SITE SKETCH

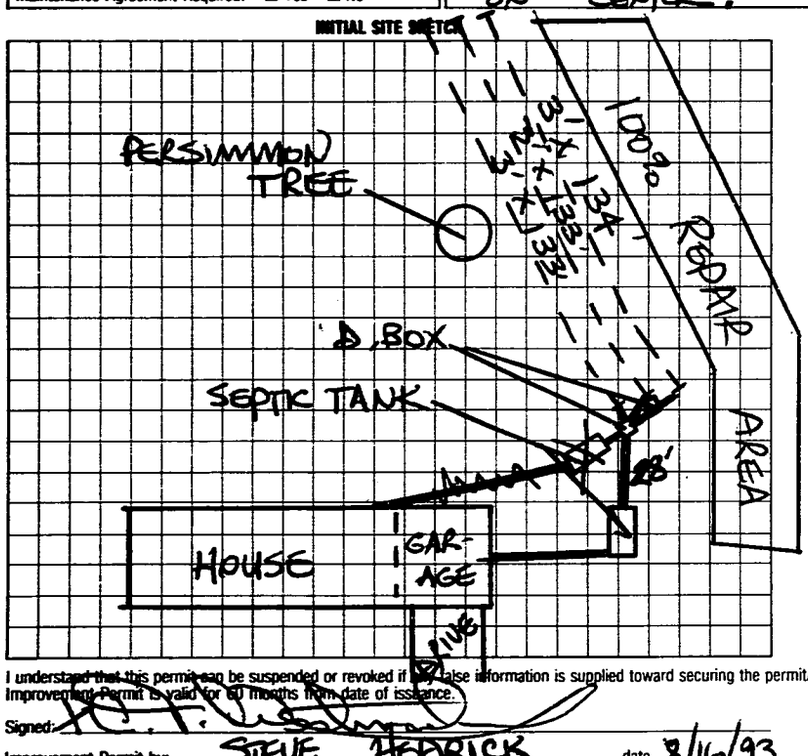

AS BUILT SKETCH

SYSTEM INSTALLED ACCORDING TO INITAL SITE SKETCH

I understand that this permit can be suspended or revoked if any false information is supplied toward securing the permit/any unauthorized changes are made to the site/any unauthorized changes are made in the installation of the system. Improvement Permit is valid for 60 months from date of issuance.

Signed: [signature]

Improvement Permit by: STEVE HEDRICK date 8/16/93

Existing System Inspection by: date

Installed by: J. WESTMORELAND (FORSYTH CO.)

Certificate of Completion by: STEVE HEDRICK date 9/1/93

Operation Permit by: date

HEALTH DEPT. COPY: WHITE INSPECTION COPY (FINAL): GREEN OWNER COPY (FINAL): YELLOW INSPECTION COPY (INITIAL): PINK OWNER COPY (INITIAL): GOLD