IREDELL COUNTY HEALTH DEPARTMENT - *ENVIRONMENTAL HEALTH* ☒ STATESVILLE OFFICE 704-878-5305 ☐ MOORESVILLE OFFICE 704-664-5281

IMPROVEMENT PERMIT / AUTHORIZATION TO CONSTRUCT / OPERATION PERMIT / EXISTING SYSTEM INSPECTION

PERMIT # 174386 PIN # 4841574569 DATE 8-27-12

OWNER Hall Moose APPLICANT: Clayton Hanes PHONE: Home/Cell # 704-873-2547 Business # N/A

SITE ADDRESS Jennings Rd. Olin NC OWNER / APPLICANT ADDRESS 2446 Jennings Rd. Olin NC

SITE DIRECTIONS Hwy 21 S TL Jennings Rd; Property on Right across from Madison Rd.

SUBDIVISION N/A BLOCK / SECTION N/A LOT # N/A LOT AREA 1.73 acres DESIGN FLOW 360 gpd L.T.A.R. 0.3

Septic Tank 1000 Gallons: STB 760 Date 3-27

Pump Tank ____ Gallons: P T ____ Date ____

Pump Make ____ Model ____ Serial # ____

No. Nitrification Fields: 1 No. Lines 4 Linear Feet 300'

Trench Width 36" Max. Trench Bottom Depth 36" Gravel Depth N/A

☑ New System ☐ Repair ☐ Expansion System Type I II III IV V VI

System Description: 25% Reduction

Repair System Description: 50% Reduction

Maintenance Agreement Required ☐ YES ☑ NO

☑ GRAVITY ☐ PRESSURE

☑ Residence No. Bedrooms 3

☐ Business No. Persons ____

☐ Other No. Employees ____

☐ Slab ☑ Crawl Space

☐ Basement w/plumbing ☐ Basement w/o plumbing

Water Supply


☐ Private

☑ Public

☐ Community

Comments / Conditions: Install a 25% Reduction System on Contour with Serial distribution. Well on property is 100' from new septic area

INITIAL SITE SKETCH

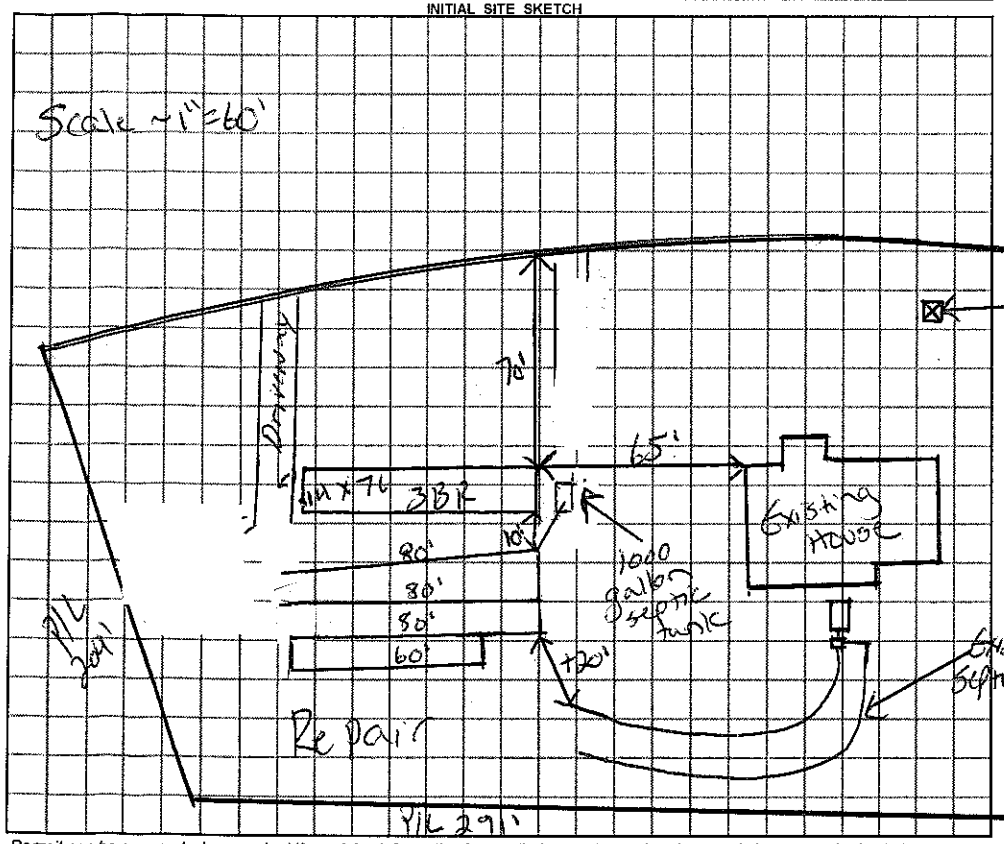

AS BUILT SKETCH

- Red Poly Jet filter installed
- Green tank marker installed
- ARC36 installed
- Installed as drawn

Permit can be suspended or revoked if any false information is supplied toward securing the permit / any unauthorized changes are made to the site / any unauthorized changes are made in the installation of the system.

☐ ***IMPROVEMENT PERMIT*** with plat valid without expiration. ☑ ***IMPROVEMENT PERMIT*** with ~~plat valid without expiration.~~ site plan valid 60 mo. ☑ ***AUTHORIZATION TO CONSTRUCT*** valid for period equal to IMPROVEMENT PERMIT–not to exceed 60 mo.

Owner / Applicant Signature: Deena Hall Date 8/28/12 Installed by: Tim Abee

IMPROVEMENT PERMIT by: Justin Rhodes REHS Date 8-27-12 OPERATION PERMIT by: Justin Rhodes REHS Date 9-10-12

AUTHORIZATION TO CONSTRUCT by: Justin Rhodes REHS Date 8-27-12 Existing System Inspected by: ____ REHS Date ____

YOU SHOULD CONTACT A LOCATOR SERVICE PRIOR TO ANY EXCAVATION

White Copy – Environmental Health YELLOW COPY (Final) Owner / Applicant PINK COPY (Initial) Owner / Applicant