43791

IREDELL COUNTY HEALTH DEPARTMENT

STATESVILLE 704-878-5305 MOORESVILLE 704-664-5281

IMPROVEMENT PERMIT / CERTIFICATE OF COMPLETION / OPERATION PERMIT / EXISTING SYSTEM INSPECTION

PROPERTY DESCRIPTION NO. 14856 DATE 10/7/93 TAX MAP NO. 13Q-A-30

OWNER OR CONTRACTOR TIM C. & CAROL JORDAN PHONE: Business Home

ADDRESS

LOCATION US 21 N, TL JENNINGS RD, LAST MH ON (L) BEFORE Mt. VERNON CH. ROAD

SUBDIVISION BLOCK / SECTION LOT LOT AREA SITE CLASS. L.T.A.R. 0.4 GPD/FT²

Water Supply: ☑ Individual ☐ Community ☐ Public WELL

Septic Tank: EXISTING Gallons; STB Date

Pump Tank: Gallons; PT Date

Nitrification Field: No Fields 1 Square Feet 300' Linear Feet 100'

No Lines 1 Trench Width 36" Trench Depth Gravel Depth 12"

☐ New System ☐ Repair System Type: I (II) III IV V VI

System Description: CONV. GRAVITY

Repair System Description:

Maintenance Agreement Required: ☐ Yes ☑ No

☐ House/Mod. Home No. Bedrooms 3

☑ Mobile Home No. Bathrooms 2

☐ Business No. Employees

☐ Other ADDITION OF 1BR

☐ Slab ☑ Crawl Space ☐ Basement w/plumbing ☐ Basement w/o plumbing

Garbage Disposal: ☐ Yes ☑ No

Auto. Dishwasher: ☑ Yes ☐ No


Auto. Washing Machine: ☑ Yes ☐ No

Other

Comments

INITIAL SITE SKETCH

AS BUILT SKETCH

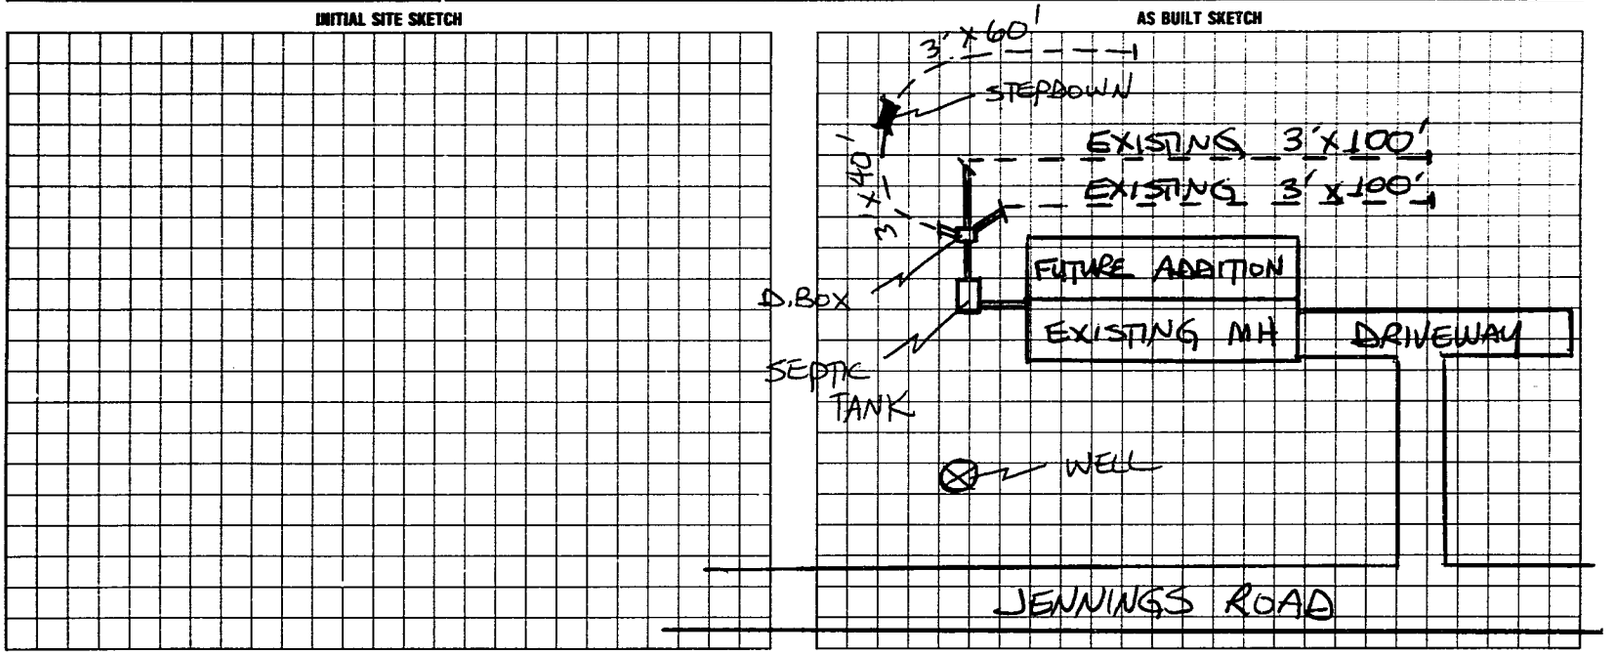

I understand that this permit can be suspended or revoked if any false information is supplied toward securing the permit/any unauthorized changes are made to the site/any unauthorized changes are made in the installation of the system. Improvement Permit is valid for 60 months from date of issuance.

Signed:

Improvement Permit by: STEVE HEDRICK date 6/30/92

Existing System Inspection by: date

Installed by: A-1 BACKHOE

Certificate of Completion by: STEVE HEDRICK date 10/7/93

Operation Permit by: date

HEALTH DEPT. COPY: WHITE INSPECTION COPY (FINAL): GREEN OWNER COPY (FINAL): YELLOW INSPECTION COPY (INITIAL): PINK OWNER COPY (INITIAL): GOLD