IREDELL COUNTY HEALTH DEPARTMENT

STATESVILLE 704-878-5305 MOORESVILLE 704-664-5281

IMPROVEMENT PERMIT / AUTHORIZATION TO CONSTRUCT / OPERATION PERMIT / EXISTING SYSTEM INSPECTION

PERMIT# 088611 PIN# 4841 67 1518 (PT) DATE 5-1-00

OWNER OR CONTRACTOR JOSEPH JESSEE PHONE: Business Home 539-5275

ADDRESS 2735 JENNINGS ROAD, OLIN NC 28660

LOCATION US 21 N, TL JENNINGS RD, 1ST HOUSE ON LEFT PAST HULL ROAD.

SUBDIVISION BLOCK / SECTION LOT LOT AREA 1.00 ACRE SITE CLASS PS DESIGN FLOW 360 L.T.A.R. 0.30 GPD/FT²

Septic Tank: 1000 Gallons; STB 160 Date 9-14-00

Pump Tank: Gallons; PT Date

Pump Make: Model Serial No.

Nitrification Field: No Fields 1 Square Feet 900 TO 1200 Linear Feet 300

No Lines FIVE Trench Width 36" Max Trench Bottom Depth 36" Bed Depth SAND 6"

☑ New System ☐ Repair System Type: I. II (III) IV. V. VI

System Description: 25% REDUCTION SYSTEM

Repair System Description: 25% REDUCTION PUMP

Maintenance Agreement Required: ☐ Yes ☑ No

☐ Slab ☐ Crawl Space ☑ Basement w/plumbing ☐ Basement wo/plumbing

☑ House/Mod. Home No. Bedrooms 3

☐ Mobile Home No. Bathrooms 2½

☐ Business No. Employees


☐ Other

Water Supply: ☐ Individual ☑ Public ☐ Community


Comments./Conditions: ① INSTALL 25% REDUCTION SYSTEM USING FIFTY (50) CHAMBERS OR THIRTY (30) HAS SECTIONS ② USE SEWAGE PUMP IN BASEMENT PLUMBING TO HPT SEWAGE TO GROUND ELEVATION

Comments /Conditions: SEPTIC TANK WITH MARKER INSTALLED USING "ZABEL" FILTER

INITIAL SITE SKETCH

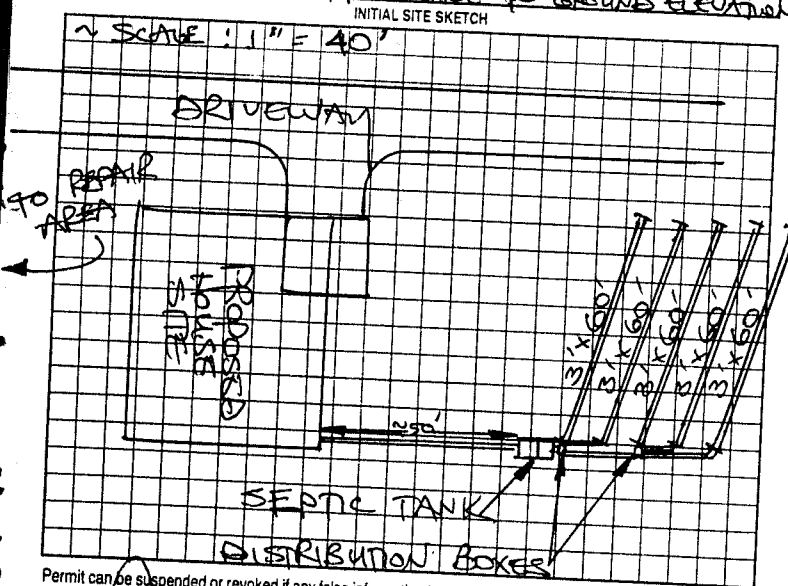

AS BUILT SKETCH

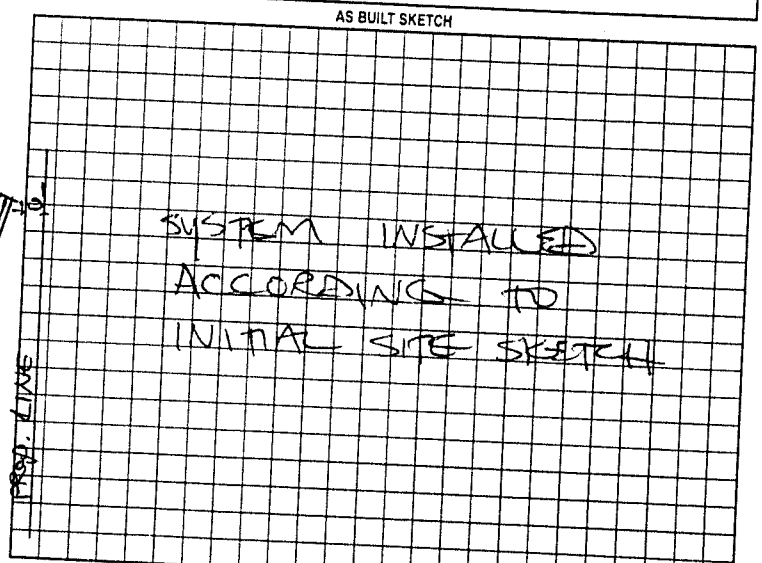

Permit can be suspended or revoked if any false information is supplied toward securing the permit/any unauthorized changes are made to the site/any unauthorized changes are made in the installation of the system. Improvement Permit with plat valid without expiration. Improvement Permit with site plan valid for sixty months. Authorization to Construct is valid for a period equal to that of Improvement Permit – not to exceed sixty months.

Signed: [signature] date 5-1-00

Improvement Permit by: STEVE HEDRICK date 5-1-00

Authorization to Construct by: STEVE HEDRICK date 5-1-00

Installed by: SHANE JARRETT

Operation Permit by: STEVE HEDRICK date 12-13-00

Existing System Inspection by: date

HEALTH DEPT. COPY: WHITE OWNER COPY (FINAL): YELLOW OWNER COPY (INITIAL): PINK