IREDELL COUNTY HEALTH DEPARTMENT

STATESVILLE 704-878-5305 MOORESVILLE 704-664-5281

IMPROVEMENT PERMIT / AUTHORIZATION TO CONSTRUCT / OPERATION PERMIT / EXISTING SYSTEM INSPECTION

PERMIT# 093823 PIN# 4844 69 8954 DATE 11/24/01

OWNER OR CONTRACTOR Jeremiah M. Sloan PHONE: ~~Business~~ (Mobile) 539-4000 Home

ADDRESS 3211 Jennings Rd Olin, N.C. 28660

LOCATION I-77N, exit Tomlin Mill Rd., (L) end of road, (R) Jennings Road, past N. Middle School (R) Hoyle Rd, Property on (R) in Field, top of hill

SUBDIVISION — BLOCK / SECTION — LOT — LOT AREA 4.10 SITE CLASS PS DESIGN FLOW 360 L.T.A.R. .25

Septic Tank: 1000 Gallons, STB 1012 Date 3-30-01
Pump Tank: Gallons; PT Date
Pump Make: Model Serial No
Nitrification Field: No Fields 1 Square Feet 1440 Linear Feet 480'
No Lines 4 Trench Width 36" Max Trench Bottom Depth 24" Gravel Depth 12"

X New System ☐ Repair System Type: I (II) III IV V VI
System Description: Gravity, Conventional
Repair System Description: Gravity, 25% Reduction
Maintenance Agreement Required: ☐ Yes ☐ No

X House/Mod Home ☐ Mobile Home ☐ Business ☐ Other
No. Bedrooms 3 No. Bathrooms 2 No. Employees


Water Supply: ☐ Individual X Public ☐ Community

☐ Slab ☐ Crawl Space ☐ Basement w/plumbing X Basement wo/plumbing


Comments/Conditions: (1) Keep System Shallow, max Trench depth 24" (2) Keep Tank 15' from [redacted] Foundation (3) Install on Contour w/ Drop Boxes (4) Call Health Dept for Inspect before installing System

Comments/Conditions: (1) SYSTEM ALTERED AS SHOWN WITH PRIOR HEALTH DEPARTMENT APPROVAL (2) SEPTIC TANK WITH MARKER INSTALLED USING "POLYLOK" FILTER

INITIAL SITE SKETCH Scale 1" = 60'

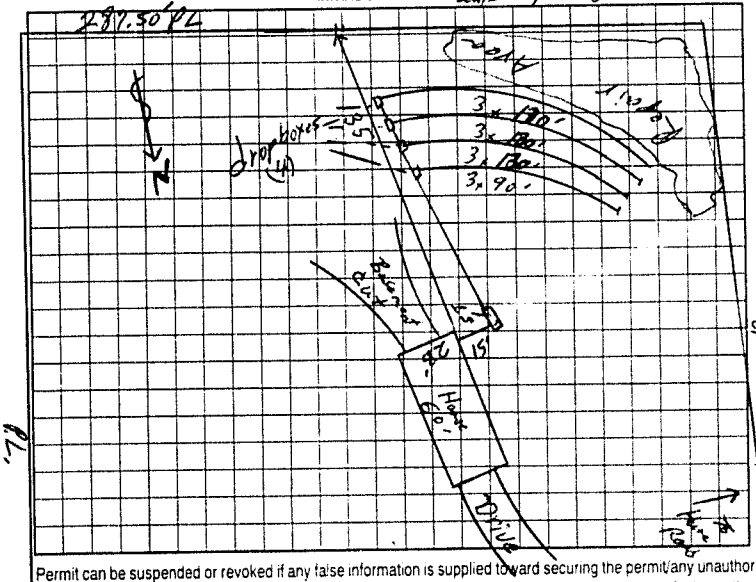

AS BUILT SKETCH

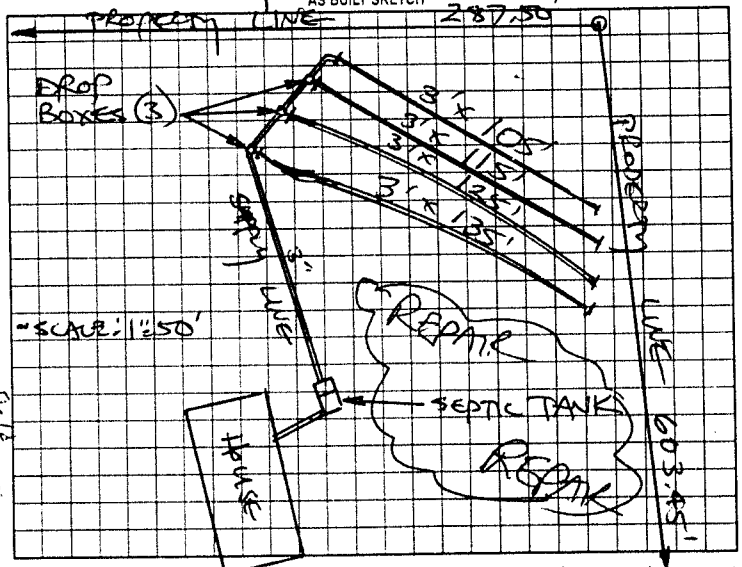

Permit can be suspended or revoked if any false information is supplied toward securing the permit/any unauthorized changes are made to the site/any unauthorized changes are made in the installation of the system. Improvement Permit with plat valid without expiration. Improvement Permit with site plan valid for sixty months. Authorization to Construct is valid for a period equal to that of Improvement Permit - not to exceed sixty months.

Signed: Mark W. Sloan date 1-25-01

Improvement Permit by: William O. Johnson date 11/24/01

Authorization to Construct by: William O. Johnson date

Installed by: A-1 BACK HOE

Operation Permit by: STEVE HENDRICK date 7-3-01

Existing System Inspection by: date

HEALTH DEPT COPY WHITE OWNER COPY (FINAL) YELLOW OWNER COPY (INITIAL) PINK