IREDELL COUNTY HEALTH DEPARTMENT

Statesville Office (704) 878-5305 Mooresville Office (704) 660-3625 PERMIT # 21760

IMPROVEMENT PERMIT / AUTHORIZATION TO CONSTRUCT / OPERATION PERMIT / EXISTING SYSTEM

PIN # 4841772962

APPLICANT: Charlotte Pools & Spas APPLICANT ADDRESS: 1458 Brawley Rd.

SITE ADDRESS: 509 Hoire Rd. PHONE: 704-799-7575 ALT. PHONE: N/A

SITE DIRECTIONS: Hwy 21 N TL Jennings Rd TR Hoire Rd. Property on Right

SUBDIVISION: R C Sloan Estate SECTION: N/A LOT # PT 1 LOT AREA: 4.5 acres DESIGN FLOW: 360 gpd L.T.A.R.: Existing


Septic Tank	Existing (gal)	STB		Date		☐ New System ☐ Repair ☐ Expansion	System Type: I (II) III IV V VI	☑ Residence	No. Bedrooms 3
Pump Tank	(gal)	PT		Date		System Description: Existing		☐ Business	No. Persons 6
Pump Make		Model		Serial #		Repair System Description:		☐ Other	No. Employees
# Nitrification Fields	Ex'	# Lines	Ex	Linear Ft:	Ex	Maintenance Agreement Required:	☐ YES ☑ NO	☐ Slab	☐ Crawl Space
Trench Width	Ex	Max. Trench Bottom Depth	Ex	Gravel Depth	Ex	☑ GRAVITY	☐ PRESSURE	☐ Basement w/plumbing	☐ Basement w/o plumbing

Water Supply: ☐ Private ☑ Public ☐ Community


Comments / Conditions:

Pool area is a minimum of 15' from all components of septic tank system & associated repair area.

INITIAL SITE SKETCH

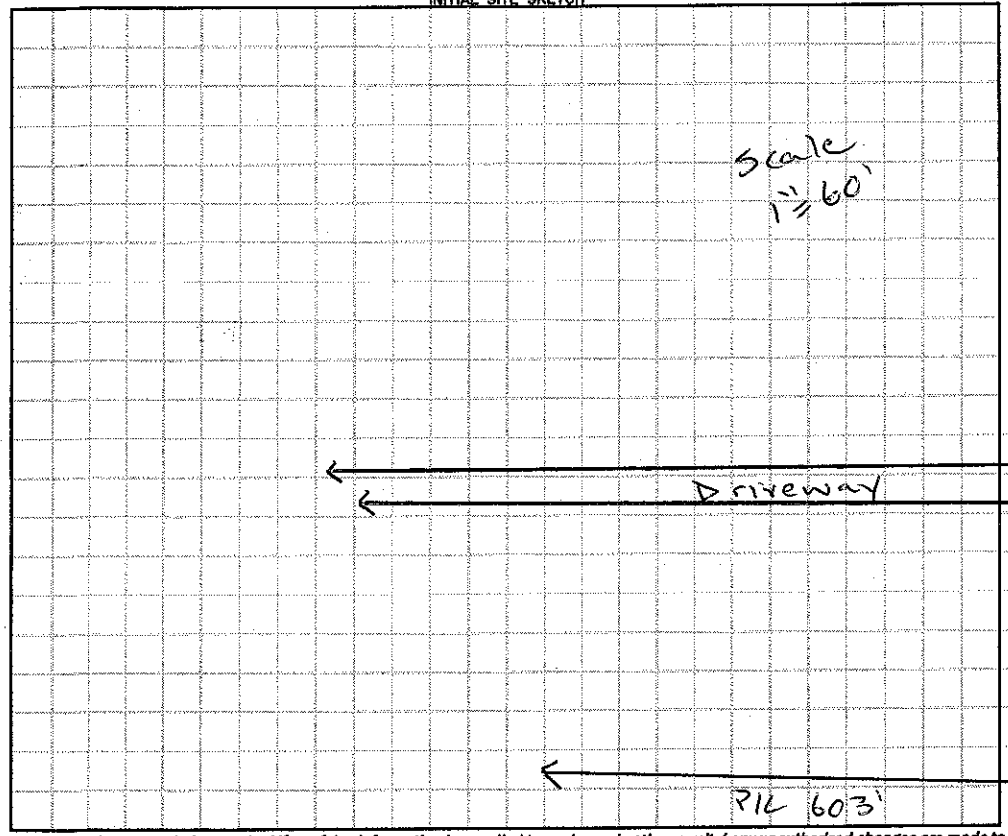

AS BUILT SKETCH

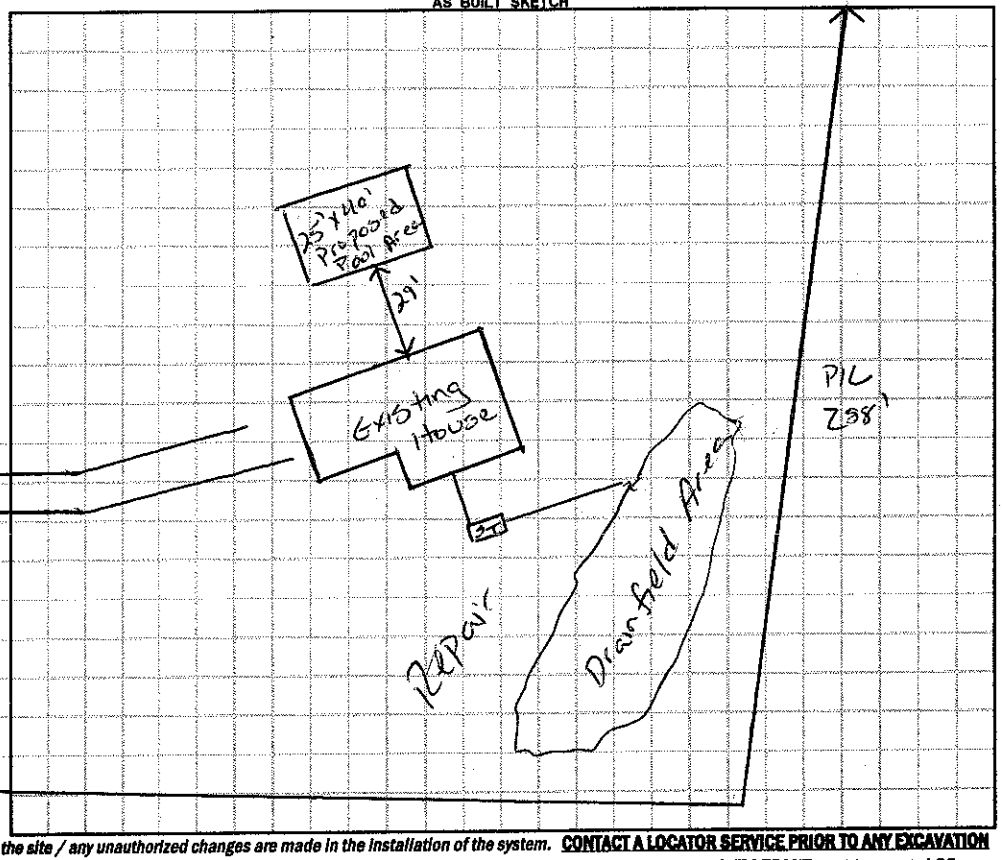

Permit can be suspended or revoked if any false information is supplied toward securing the permit / any unauthorized changes are made to the site / any unauthorized changes are made in the installation of the system. **CONTACT A LOCATOR SERVICE PRIOR TO ANY EXCAVATION**

☐ **IMPROVEMENT PERMIT** *with plat valid without expiration.* ☐ **IMPROVEMENT PERMIT** *with site plan valid for 60 mos.* ☐ **AUTHORIZATION TO CONSTRUCT** *valid for period equal to IMPROVEMENT PERMIT--not to exceed 60 mo.*

Owner / Applicant Signature: Colleen A Rippon Date: 7/21/15 Installed by:

IMPROVEMENT PERMIT by: Date: OPERATION PERMIT by: Date:

AUTHORIZATION TO CONSTRUCT by: Date: Existing System Inspected by: Justin Henderson Date: 7-20-15

Health Dept. Copy - WHITE Applicant (Final Approval) - YELLOW Applicant (Conditional Approval) - PINK