IREDELL COUNTY HEALTH DEPARTMENT

(CI) This replaces drawing issued 7-27-05

STATESVILLE 704-878-5305 MOORESVILLE 704-664-5281

IMPROVEMENT PERMIT / AUTHORIZATION TO CONSTRUCT / OPERATION PERMIT / EXISTING SYSTEM INSPECTION

PERMIT# 129916 PIN# 4841809051 9D1000 DATE 4-26-06

OWNER OR APPLICANT Judy Martz PHONE: Business 704-876-2423 Home

ADDRESS 1053 Olin Loop

LOCATION Tomlin Mill (R) on Jennings 2nd entrance to Olin Loop Rd, prop on (R)

SUBDIVISION BLOCK / SECTION LOT LOT AREA 20. Acres SITE CLASS. PS DESIGN FLOW 180 L.T.A.R. .3

Septic Tank: 1000 Gallons; STB 794 Date 4-21-06

Pump Tank: Gallons; PT Date

Pump Make: Model Serial No.

Nitrification Field: No Fields 1 Square Feet 333. Linear Feet 112

No Lines 2 Trench Width 36" Max Trench Bottom Depth 36"

☑ New System ☐ Repair ☐ Expansion System Type: I (II) III IV V VI

System Description: Gravity Conventional

Repair System Description: Gravity Conventional

Maintenance Agreement Required: ☐ Yes ☑ No

☑ House/Mod. Home No. Bedrooms 3 (2)

☐ Mobile Home No. Persons

☐ Business No. Employees

☐ Other Garage w/Bath

Water Supply: ☑ Individual ☐ Public ☐ Community


Gravel Depth 12" ☑ Gravity ☐ Pressure ☐ Slab ☑ Crawl Space ☐ Basement w/plumbing ☐ Basement wo/plumbing

Comments:/Conditions:


An approved system may also be used

Comments:/Conditions:

INITIAL SITE SKETCH

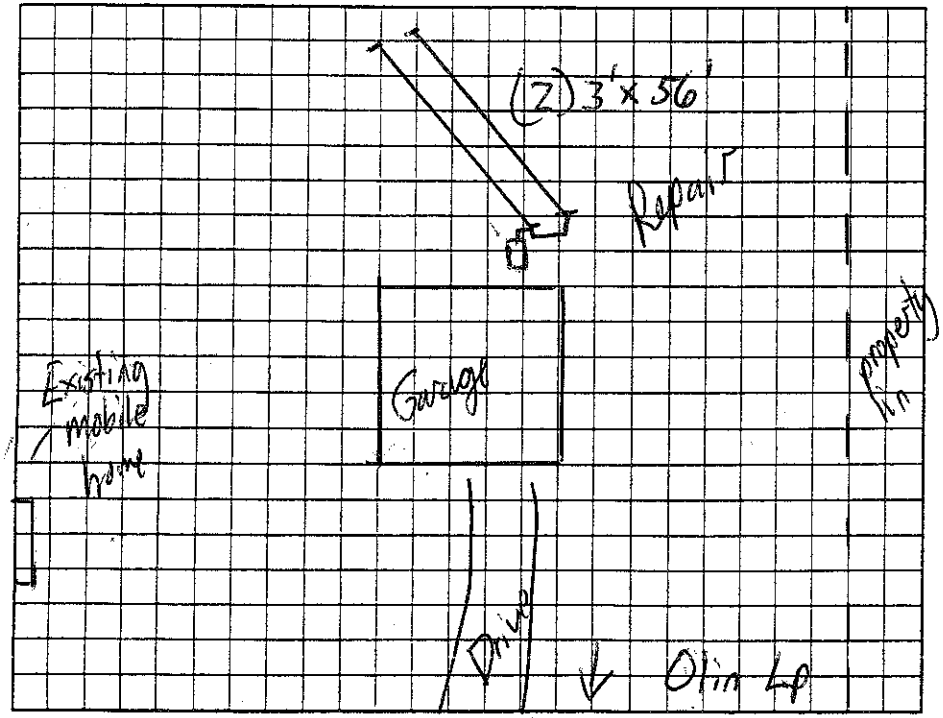

AS BUILT SKETCH

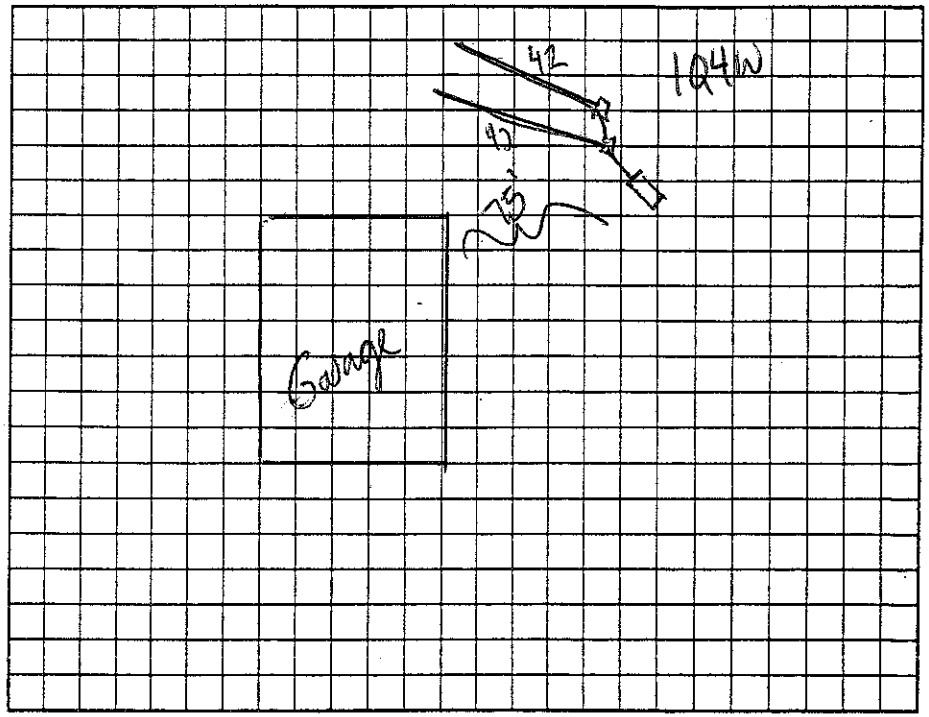

Permit can be suspended or revoked if any false information is supplied toward securing the permit/any unauthorized changes are made to the site/any unauthorized changes are made in the installation of the system. Improvement Permit with plat valid without expiration. ☐ Improvement Permit with site plan valid for sixty months ☐ Authorization to Construct is valid for a period equal to that of Improvement Permit – not to exceed sixty months.

Signed: date 4-26-06 Installed by: Kenny Madison

Improvement Permit by: date 4-26-06 Operation Permit by: date 11/17/06

Authorization to Construct by: date 4-26-06 Existing System Inspection by: date

HEALTH DEPT. COPY: WHITE OWNER COPY (FINAL): YELLOW OWNER COPY (INITIAL): PINK