IREDELL COUNTY HEALTH DEPARTMENT

STATESVILLE 704-878-5305 MOORESVILLE 704-664-5281

IMPROVEMENT PERMIT / AUTHORIZATION TO CONSTRUCT / OPERATION PERMIT / EXISTING SYSTEM INSPECTION

PERMIT# L33742 PIN# 4842053425 # 41585 DATE 2-24-06

OWNER OR CONTRACTOR Gary Bustle PHONE: Business Home 704-593-2108

ADDRESS 188 Branton Rd Union Grove NC 28689

LOCATION 21N (I) Jennings Rd (L) Euepetae Springs property on left

SUBDIVISION BLOCK / SECTION LOT LOT AREA 2.947 SITE CLASS. I DESIGN FLOW 360 L.T.A.R. e.25

Septic Tank: 1000 Gallons; STB WP 1000 STD 1000 Date 8-15-06

Pump Tank: Gallons; PT Date

Pump Make: Model Serial No.

Nitrification Field: No Fields Square Feet 1440 Linear Feet 360

No Lines 3 Trench Width 36" Max Trench Bottom Depth 24 Gravel Depth NA

☑ New System ☐ Repair System Type: I, II, III, IV, V, VI

System Description: 25% Green

Repair System Description: 25% Green

Maintenance Agreement Required: ☐ Yes ☐ No

☑ House/Mod. Home No. Bedrooms 3

☐ Mobile Home No. Bathrooms

☐ Business No. Employees

☐ Other

☐ Slab ☑ Crawl Space ☐ Basement w/plumbing ☐ Basement wo/plumbing


Water Supply: ☐ Individual ☑ Public ☐ Community

Comments/Conditions:

(Not to scale)

Distribution box with 3 speed levels

INITIAL SITE SKETCH

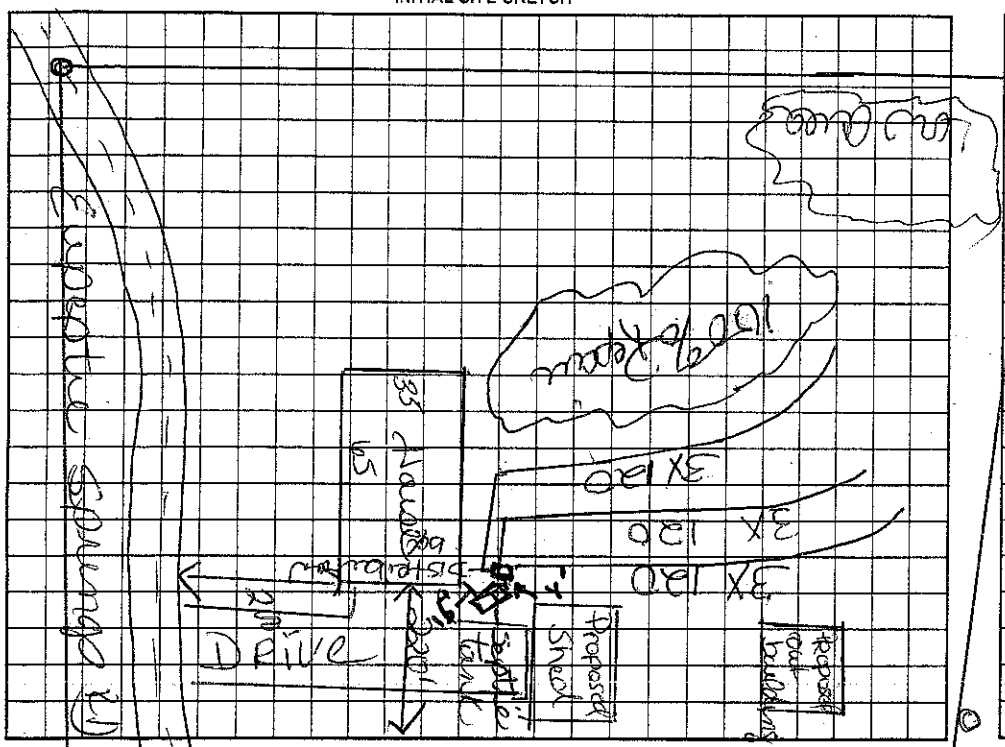


Comments/Conditions:

Install on Contour

Maintain all setbacks

Quick-4 90 panels.

AS BUILT SKETCH

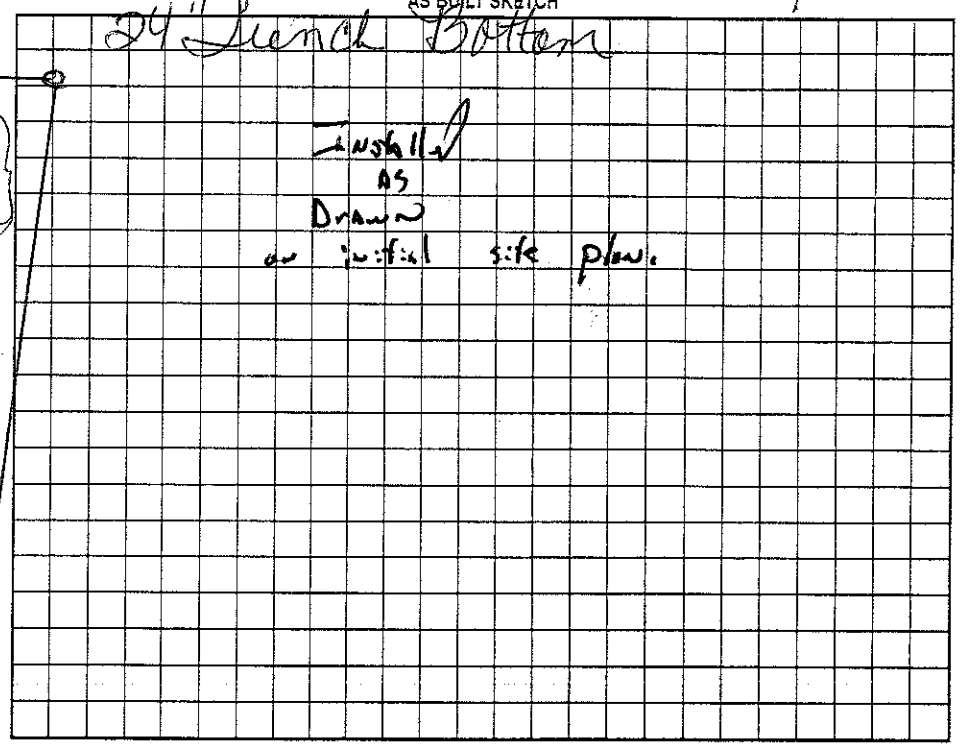

Permit can be suspended or revoked if any false information is supplied toward securing the permit/any unauthorized changes are made to the site/any unauthorized changes are made in the installation of the system. Improvement Permit with plat valid without expiration. Improvement Permit with site plan valid for sixty months. Authorization to Construct is valid for a period equal to that of Improvement Permit – not to exceed sixty months.

Signed: Gary L Bustle date

Improvement Permit by: Kelly Cook date 2-24-06

Authorization to Construct by: Kelly Cook date 9-14-06

Installed by: Union Grove Septic

Operation Permit by: Jim Nagy, R.S. date 26 Sept 06

Existing System Inspection by: date

HEALTH DEPT. COPY: WHITE OWNER COPY (FINAL): YELLOW OWNER COPY (INITIAL): PINK