THIS PERMIT VOIDS PREVIOUS ISSUED 1-23-97

IREDELL COUNTY HEALTH DEPARTMENT

STATESVILLE 704-878-5305 (C1) MOORESVILLE 704-664-5281

IMPROVEMENT PERMIT / AUTHORIZATION TO CONSTRUCT / OPERATION PERMIT / EXISTING SYSTEM INSPECTION

(C) (L)

PERMIT# 087318 PIN# 4842-07-3967 DATE 3-20-02

OWNER OR CONTRACTOR HARRY L. RUDDY PHONE: Business 704-902-2882 Home 704-539-4065

ADDRESS 321 BUZZARD LANE, OLIN NC 28660

LOCATION US 21 N, TL JENNINGS RD, TL EUREKA SPRINGS RD, TR GURNEY RD, TR BUZZARD LANE TO END on (L)

SUBDIVISION _____ BLOCK / SECTION _____ LOT _____ LOT AREA 44.285 ACRES SITE CLASS P3 DESIGN FLOW 360 L.T.A.R. 0.30 GAD/FT²

Septic Tank: 1000 Gallons: STB 1012 Date 10-9-01
Pump Tank: _____ Gallons; PT _____ Date _____
Pump Make: _____ Model _____ Serial No. _____
Nitrification Field: No Fields 1 Square Feet 1200 Linear Feet 400
No Lines FIVE Trench Width 36" Max Trench Bottom Depth (30") Gravel Depth 12"

☒ New System ☐ Repair System Type: I (II) III IV V VI
System Description: CONVENTIONAL GRAVITY
Repair System Description: CONVENTIONAL GRAVITY
Maintenance Agreement Required: ☐ Yes ☒ No
☐ Slab ☒ Crawl Space ☐ Basement w/plumbing ☐ Basement wo/plumbing


☒ House/Mod. Home No. Bedrooms 3
☐ Mobile Home No. Bathrooms 2
☐ Business No. Employees _____
☐ Other _____

Water Supply: ☒ Individual ☐ Public ☐ Community
WELL

Comments/Conditions:

Comments/Conditions: SEPTIC TANK WITH MARKER INSTALLED USING "POLYLOK" FILTER

INITIAL SITE SKETCH

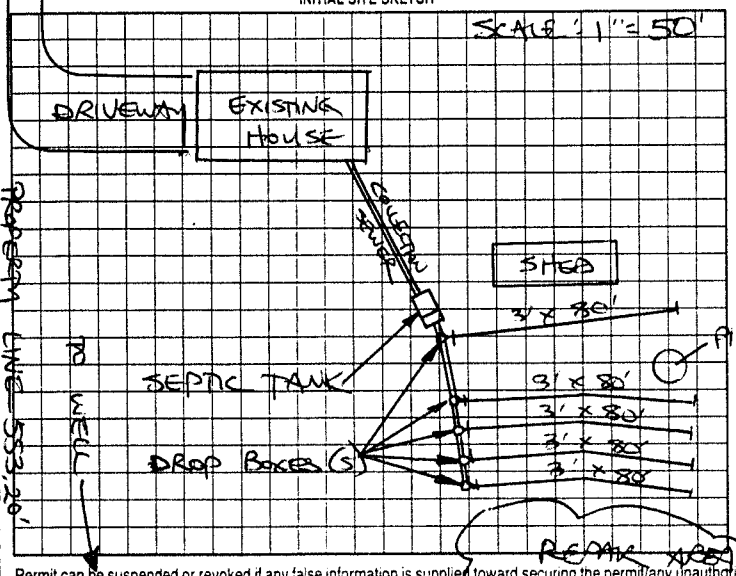

AS BUILT SKETCH

SYSTEM INSTALLED ACCORDING TO INITIAL SITE SKETCH

Permit can be suspended or revoked if any false information is supplied toward securing the permit/any unauthorized changes are made to the site/any unauthorized changes are made in the installation of the system. Improvement Permit with plat valid without expiration. Improvement Permit with site plan valid for sixty months. Authorization to Construct is valid for a period equal to that of Improvement Permit – not to exceed sixty months.

Signed: x Harry L Ruddy Jr. date 3-20-02 Installed by: A-1 BACKHOE

Improvement Permit by: STEVE HEDRICK date 3-20-02 Operation Permit by: STEVE HEDRICK date 3-22-02

Authorization to Construct by: STEVE HEDRICK date 3-20-02 Existing System Inspection by: _____ date _____

HEALTH DEPT COPY WHITE OWNER COPY (FINAL) YELLOW OWNER COPY (INITIAL) PINK