IREDELL COUNTY HEALTH DEPARTMENT

STATESVILLE 704-878-5305 CI MOORESVILLE 704-664-5281

IMPROVEMENT PERMIT / AUTHORIZATION TO CONSTRUCT / OPERATION PERMIT / EXISTING SYSTEM INSPECTION

PERMIT# 115588 PIN# 4842-12-0583 BECKY COMER 704-880-0310 (CELL) DATE 9-26-03

OWNER OR CONTRACTOR JONATHON WHITE PHONE: Business 704-872-4625 Home 704-876-4191 NIHS

ADDRESS 238 TRUMPET BRANCH RD OLIN, NC 28660

LOCATION JENNINGS RD NORTH, (L) TRUMPET BRANCH, 3/4 mile on Right PAST BIG WHITE HOUSE

SUBDIVISION _____ BLOCK / SECTION _____ LOT _____ LOT AREA 7.0 AC SITE CLASS. PS DESIGN FLOW 480 L.T.A.R. .3

Septic Tank: 1000 Gallons; STB 760 Date 6-24-03
Pump Tank: _____ Gallons; PT _____ Date _____
Pump Make: _____ Model _____ Serial No. _____
Nitrification Field: No Fields 1 Square Feet 1600' Linear Feet 533'
No Lines 4x133' Trench Width 36" Max Trench Bottom Depth 36" Gravel Depth 12"

☒ New System ☐ Repair System Type: I, (II) III, IV, V, VI
System Description: CONV GRAV
Repair System Description: SAME
Maintenance Agreement Required: ☐ Yes ☒ No


☐ House/Mod. Home No. Bedrooms 3
☒ Mobile Home SW No. Bathrooms 2
☐ Business No. Employees ___
☐ Other _____
☐ Slab ☒ Crawl Space ☐ Basement w/plumbing ☐ Basement wo/plumbing

Water Supply: ☐ Individual ☒ Public ☐ Community


Comments:/Conditions: (1) SYSTEM IS COMPLETELY FLAGGED OUT (2) ONLY PLANNING 3 BEDROOM HOME ON SYSTEM; SYSTEM IS SIZED FOR A 4 BEDROOM HOME. (3) WHEN FUTURE BASEMENT HOME IS BUILT, MAINTAIN [redacted] PROPER

Comments:/Conditions: BASEMENT ELEVATIONS IS CRITICAL FOR EXISTING SYSTEM TO BE UTILIZED. IF NOT A PUMP SYSTEM WILL BE THE ONLY ALTERNATIVE. (4) MAINTAIN PROPER SETBACKS. (5) DEPENDING ON THE BASEMENT CUT DESIGN IN THE FUTURE, A NEW TANK MAY BE REQUIRED FOR THE BASEMENT HOME.

"NOT TO SCALE" INITIAL SITE SKETCH

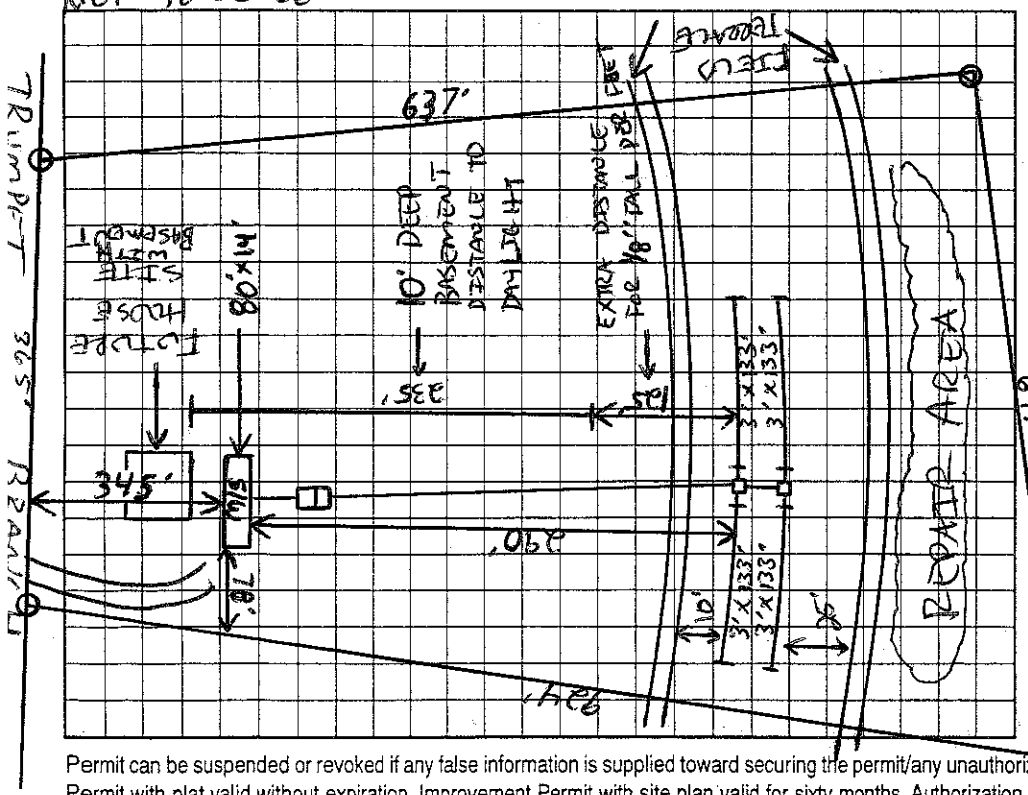

AS BUILT SKETCH

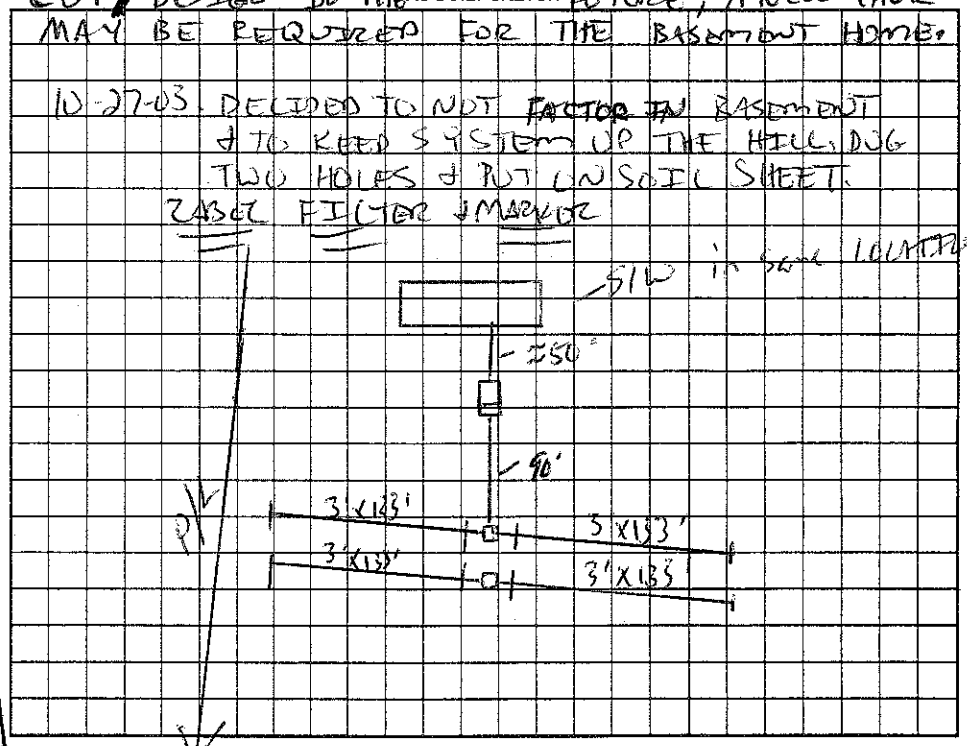

10-27-03 DECIDED TO NOT FACTOR IN BASEMENT & TO KEEP SYSTEM UP THE HILL, DUG TWO HOLES & PUT ON SOIL SHEET. LABEL FLAGS & MARKER

Permit can be suspended or revoked if any false information is supplied toward securing the permit/any unauthorized changes are made to the site/any unauthorized changes are made in the installation of the system. Improvement Permit with plat valid without expiration. Improvement Permit with site plan valid for sixty months. Authorization to Construct is valid for a period equal to that of Improvement Permit – not to exceed sixty months.

Signed: Jonathon B White date 9/25/03 Installed by: BRENT GALLEHARE

Improvement Permit by: _____ date 9-26-03 Operation Permit by: _____ date 10-28-03

Authorization to Construct by: _____ date 9-26-03 Existing System Inspection by: _____ date _____

HEALTH DEPT. COPY: WHITE OWNER COPY (FINAL): YELLOW OWNER COPY (INITIAL): PINK